IREDELL COUNTY HEALTH DEPARTMENT

STATESVILLE 704-878-5305 — MOORESVILLE 704-664-5281

IMPROVEMENT PERMIT / AUTHORIZATION TO CONSTRUCT / OPERATION PERMIT / EXISTING SYSTEM INSPECTION

PERMIT# 109942 PIN# 4669000591 DATE 11-12-2002

OWNER OR CONTRACTOR ES Johnson PHONE: Business 634-5704 Home

ADDRESS P.O. Box 1402 Cornelius NC 28031

LOCATION Hwy 115 N TR Shinnville TL Brookglen corner of Rocky Pt

SUBDIVISION Brookglen BLOCK / SECTION 1 LOT 48 LOT AREA SITE CLASS PS DESIGN FLOW 360gpd L.T.A.R.

Septic Tank: 1000 Gallons; STB Date

Pump Tank: Gallons; PT Date

Pump Make: Model Serial No.

Nitrification Field: No Fields 1 Square Feet 1200 Linear Feet 400

No Lines 5 Trench Width 36" Max Trench Bottom Depth 36" Gravel Depth 12"

☐ New System ☐ Repair System Type: I, II, III, IV, V, VI

System Description: Existing Gravity - Conventional

Repair System Description: Pump - Panel Blk

Maintenance Agreement Required: ☐ Yes ☐ No

☐ House/Mod. Home No. Bedrooms 3

☐ Mobile Home No. Bathrooms 3

☐ Business No. Employees

☒ Other Detached Garage


☐ Slab ☒ Crawl Space ☐ Basement w/plumbing ☐ Basement wo/plumbing

Water Supply: ☒ Individual ☐ Public ☐ Community


Comments/Conditions: Existing System Appears to be functioning okay.

Comments/Conditions: Okay to Construct detached garage. Septic repair field will probably be Panel Block.

INITIAL SITE SKETCH

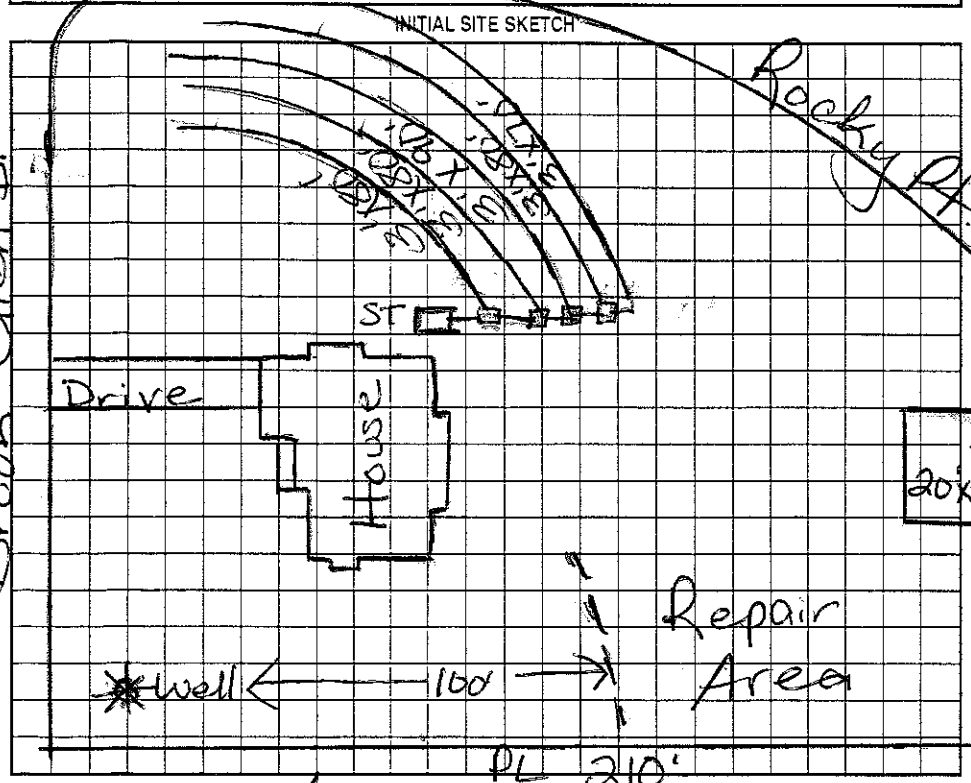

AS BUILT SKETCH

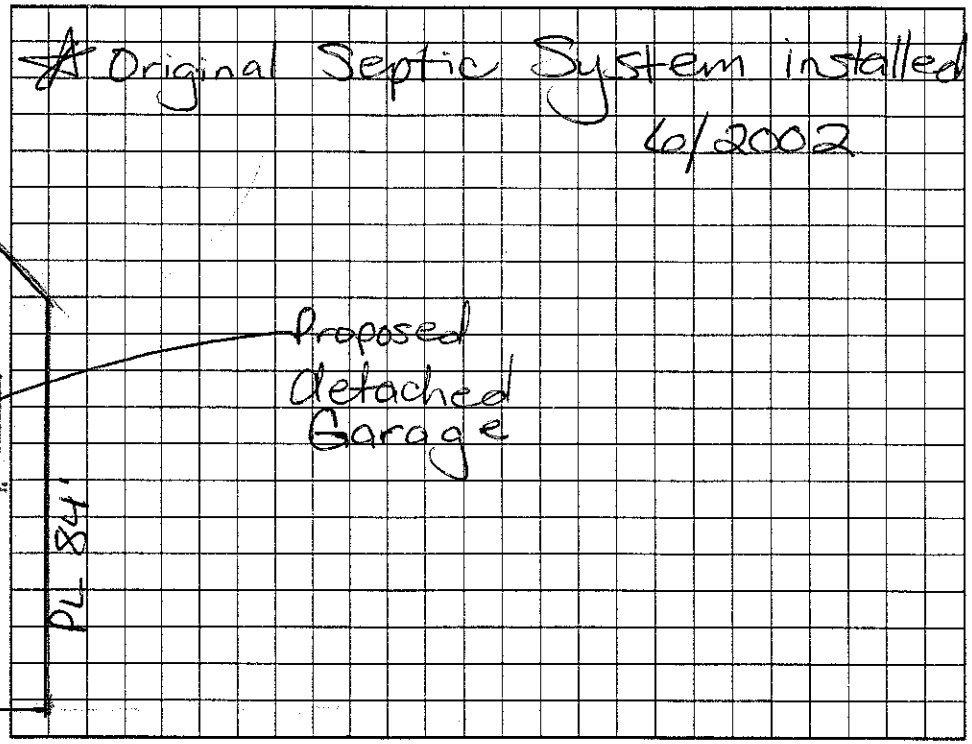

Permit can be suspended or revoked if any false information is supplied toward securing the permit/any unauthorized changes are made to the site/any unauthorized changes are made in the installation of the system. Improvement Permit with plat valid without expiration. Improvement Permit with site plan valid for sixty months. Authorization to Construct is valid for a period equal to that of Improvement Permit – not to exceed sixty months.

Signed: date 3-03-03 Installed by:

Improvement Permit by: RS date 11/12/02 Operation Permit by: date

Authorization to Construct by: date Existing System Inspection by: RS date 11/12/02

HEALTH DEPT. COPY: WHITE OWNER COPY (FINAL): YELLOW OWNER COPY (INITIAL): PINK