IREDELL COUNTY HEALTH DEPARTMENT

STATESVILLE 704-878-5305 MOORESVILLE 704-664-5281

IMPROVEMENT PERMIT / AUTHORIZATION TO CONSTRUCT / OPERATION PERMIT / EXISTING SYSTEM INSPECTION

PERMIT# 08 9260 PIN# 4669003656 PT DATE 10/31/01

OWNER OR CONTRACTOR KFS INVESTMENTS / E.S. Johnson PHONE: Business 664-3671 Home

ADDRESS 149 YACHT COVE LN MOORESVILLE NC

LOCATION I-77 N - TR SHINNVILLE - TL BROOKGLEN. CORNER OF ROCKY PT

SUBDIVISION BROOKGLEN BLOCK / SECTION LOT 48 LOT AREA .68AC SITE CLASS. PS DESIGN FLOW 360GPD L.T.A.R. .36PD/VT2

Septic Tank: 1000 Gallons; STB 1012 Date 10-2-01
Pump Tank: Gallons; PT Date
Pump Make: Model Serial No.
Nitrification Field: No Fields 1 Square Feet 1200 Linear Feet 400
No Lines 5@80' Trench Width 36" Max Trench Bottom Depth 36" Gravel Depth 12"

☑ New System ☐ Repair System Type: I, II, III, IV, V, VI
System Description: GRAVITY CONVENTIONAL
Repair System Description: PUMP INNOVATIVE
Maintenance Agreement Required: ☐ Yes ☑ No

☑ House/Mod. Home No. Bedrooms 3
☐ Mobile Home No. Bathrooms 3
☐ Business No. Employees
☐ Other


☐ Slab ☑ Crawl Space ☐ Basement w/plumbing ☐ Basement wo/plumbing

Water Supply: ☑ Individual ☐ Public ☐ Community


Comments/Conditions: KEEP WELL 100' FROM SYSTEM

Comments/Conditions: Note: Detached garage permitted 11/12/02

INITIAL SITE SKETCH 1" = 50'

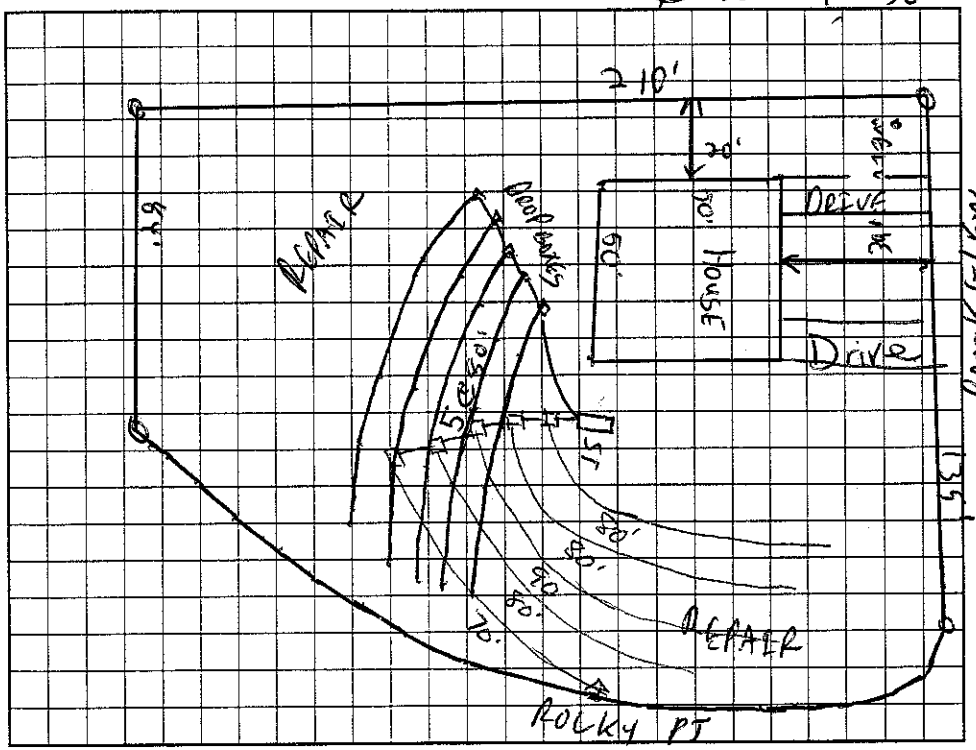

AS BUILT SKETCH

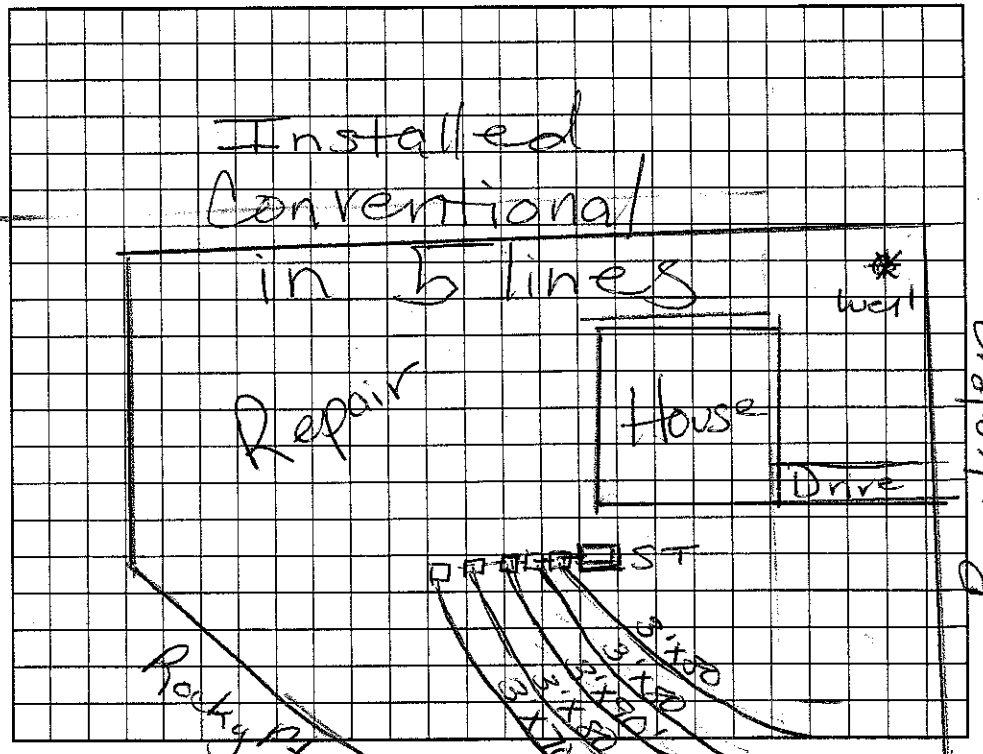

Permit can be suspended or revoked if any false information is supplied toward securing the permit/any unauthorized changes are made to the site/any unauthorized changes are made in the installation of the system. Improvement Permit with plat valid without expiration. Improvement Permit with site plan valid for sixty months. Authorization to Construct is valid for a period equal to that of Improvement Permit – not to exceed sixty months.

Signed: date 11.6.01

Improvement Permit by: RS date 10/31/01

Authorization to Construct by: RS date 2/4/02

Installed by: Tommy Fr RS

Operation Permit by: Marvin H. Dotson date 6/18/02

Existing System Inspection by: date

HEALTH DEPT. COPY: WHITE OWNER COPY (FINAL): YELLOW OWNER COPY (INITIAL): PINK