rt before lunch

IREDELL COUNTY HEALTH DEPARTMENT

STATESVILLE 704-878-5305 MOORESVILLE 704-664-5281

IMPROVEMENT PERMIT / AUTHORIZATION TO CONSTRUCT / OPERATION PERMIT / EXISTING SYSTEM INSPECTION

PERMIT# ~~6390~~ 89105 PIN# ~~4664003656~~ 4669-00-0624 DATE 11/16/00

OWNER OR CONTRACTOR MIKE KROM PHONE: Business 664-3671 Home

ADDRESS 194 YACHT COVE LN - MOORESVILLE - NC 28115

LOCATION ~~I-77 EXIT 33~~ 115 N - TR SHINNVILLE - TL BROOKGLEN - TL ROCKY POINT

SUBDIVISION BROOKGLEN BLOCK / SECTION 1 LOT 40 LOT AREA .93 SITE CLASS. PS DESIGN FLOW 360GPD L.T.A.R. .3 gal/sq ft

Septic Tank: 1000 Gallons; STB 312 Date 10/29/99

Pump Tank: Gallons; PT Date

Pump Make: Model Serial No.

Nitrification Field: No Fields 1 Square Feet 900 Linear Feet 300

No Lines 6@50' Trench Width 36" Max Trench Bottom Depth 24" Gravel Depth N/A

☑ New System ☐ Repair System Type: I, II, (III), IV, V, VI

System Description: GRAVITY 25% REDUCTION

Repair System Description: PUMP SAME

Maintenance Agreement Required: ☐ Yes ☑ No

☑ House/Mod. Home No. Bedrooms 3

☐ Mobile Home No. Bathrooms 3

☐ Business No. Employees

☐ Other


☐ Slab ☑ Crawl Space ☐ Basement w/plumbing ☐ Basement wo/plumbing

Water Supply: ☑ Individual ☐ Public ☐ Community


Comments:/Conditions:

Comments:/Conditions:

1"=50' INITIAL SITE SKETCH

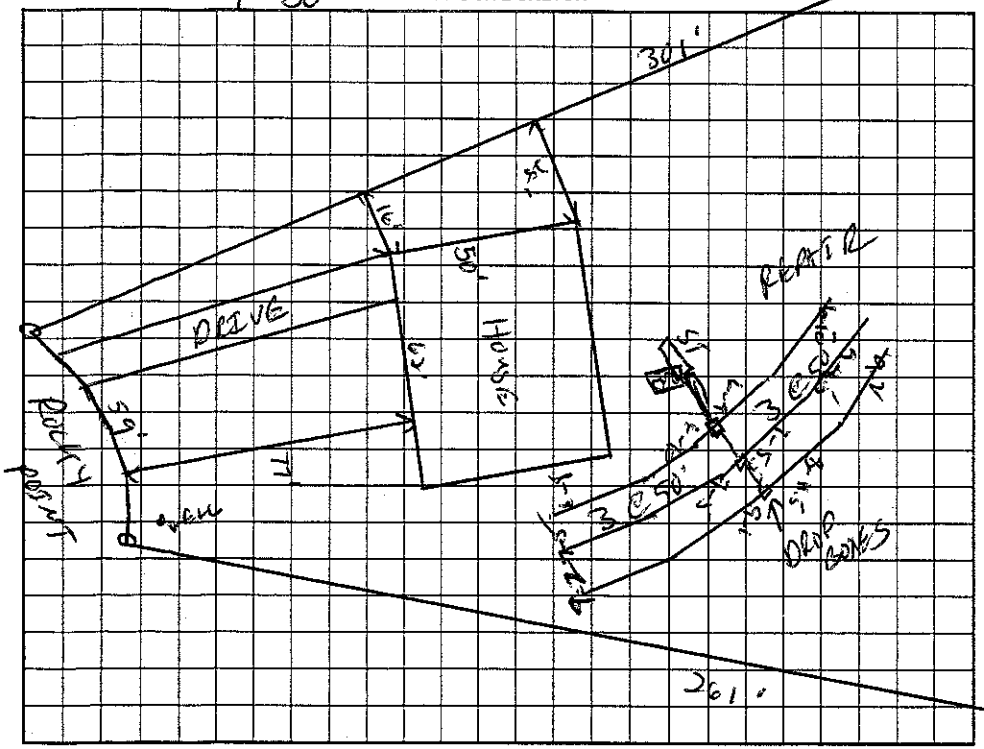

AS BUILT SKETCH

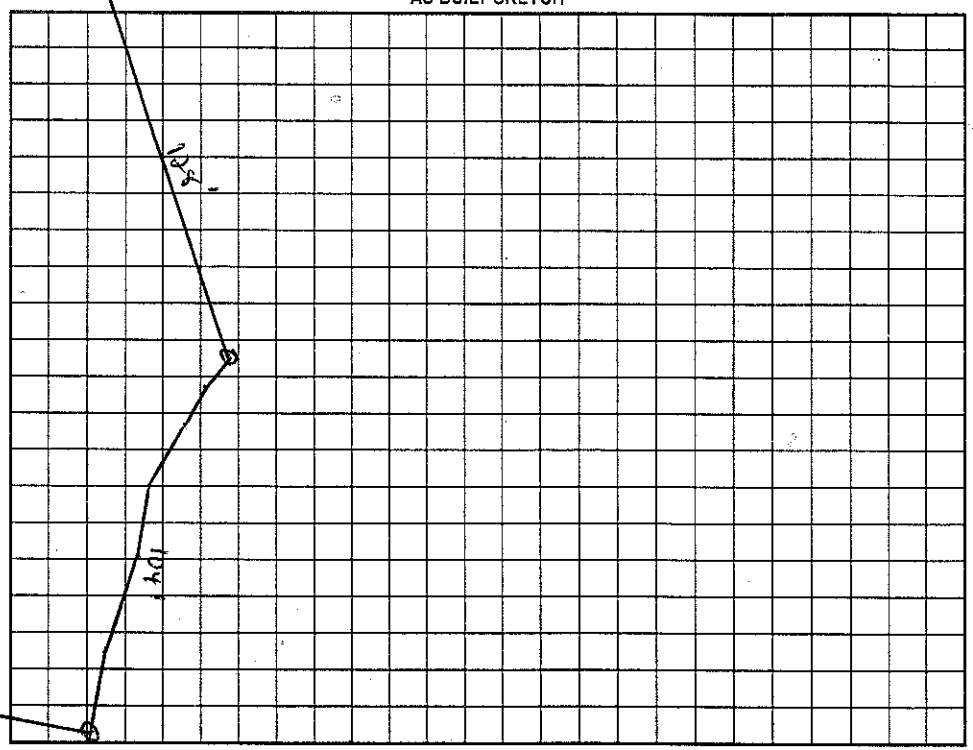

Permit can be suspended or revoked if any false information is supplied toward securing the permit/any unauthorized changes are made to the site/any unauthorized changes are made in the installation of the system. Improvement Permit with plat valid without expiration. Improvement Permit with site plan valid for sixty months. Authorization to Construct is valid for a period equal to that of Improvement Permit – not to exceed sixty months.

Signed: date 11/21/00 Installed by: Tommy Fayes

Improvement Permit by: date 11/16/00 Operation Permit by: Wesley Sparks R.S. date 4/6/01

Authorization to Construct by: date 11/16/00 Existing System Inspection by: date

HEALTH DEPT. COPY: WHITE OWNER COPY (FINAL): YELLOW OWNER COPY (INITIAL): PINK