IREDELL COUNTY HEALTH DEPARTMENT

STATESVILLE 704-878-5305 125.00 Paid MOORESVILLE 704-664-5281

IMPROVEMENT PERMIT / AUTHORIZATION TO CONSTRUCT / OPERATION PERMIT / EXISTING SYSTEM INSPECTION

PERMIT# 089265 PIN# 4669003656 PT 4669-00-1172 DATE 10/29/01

OWNER OR CONTRACTOR ~~KR~~ KFS INVESTMENTS / Cawkins PHONE: Business 664-3671 Home

ADDRESS 149 YACHT COVE · MOORESVILLE NC 28117

LOCATION 115 N- TR SHINNVILLE - TL BROOKGLEN - TL ROCKY PT - ON LT #127

SUBDIVISION BROOKGLEN BLOCK / SECTION LOT 35 LOT AREA .66AC SITE CLASS. PS DESIGN FLOW 360GPD L.T.A.R. .30-00/R12

Septic Tank: 1000 Gallons; STB 312 Date 3-30-03 ☑ New System ☐ Repair System Type: I, II, III, IV, V, VI

Pump Tank: 1000 Gallons; PT 29 Date 4-19-03 System Description: PUMP 25% REDUCTION

Pump Make: Zoeller Model P4HP Serial No. Repair System Description: LP LANG L

Nitrification Field: No Fields 1 Square Feet 900 Linear Feet 300 Maintenance Agreement Required: ☐ Yes ☑ No

No Lines 3 @100' Trench Width 36" Max Trench Bottom Depth 36" Gravel Depth N/A

☑ House/Mod. Home No. Bedrooms 3 ☐ Mobile Home No. Bathrooms 3 ☐ Business No. Employees ☐ Other


☐ Slab ☑ Crawl Space ☐ Basement w/plumbing ☐ Basement wo/plumbing

Water Supply: ☑ Individual ☐ Public ☐ Community

Comments:/Conditions: 1) WELL TO BE 100' FROM SEPTIC SYSTEM. Reviewed Site plans & building plans 4/24/03. Essentially in compliance with original permit.

Comments/Conditions: 10/26/03 Checked tanks, lines & pressure

INITIAL SITE SKETCH 1" = 50'

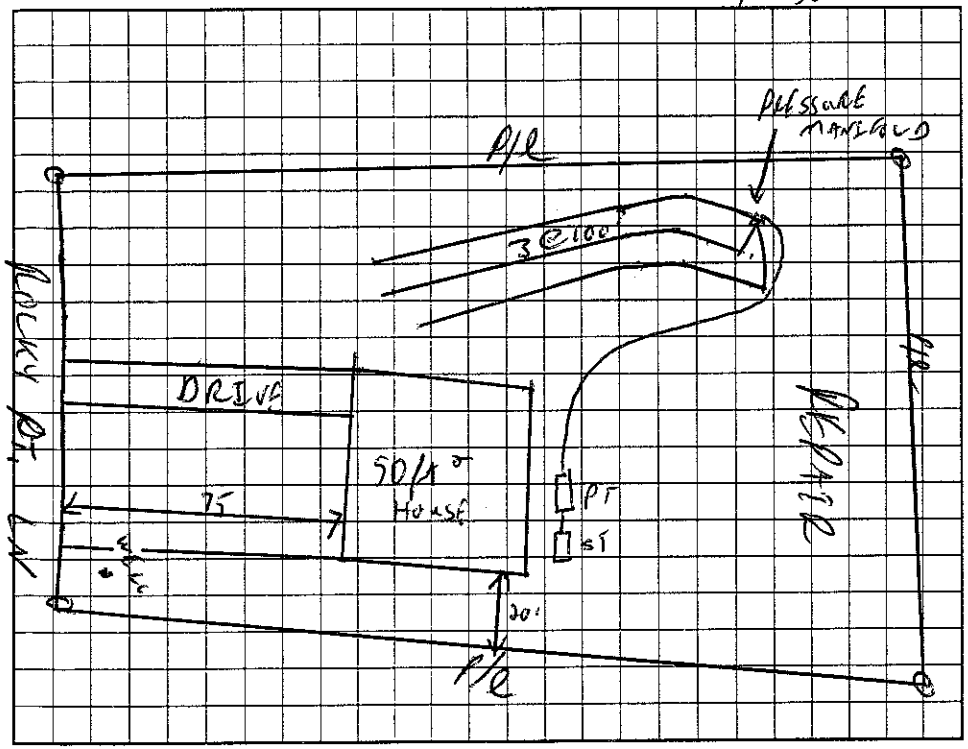

AS BUILT SKETCH

EZ Flow Installed as Drawn

Permit can be suspended or revoked if any false information is supplied toward securing the permit/any unauthorized changes are made to the site/any unauthorized changes are made in the installation of the system. Improvement Permit with plat valid without expiration. Improvement Permit with site plan valid for sixty months. Authorization to Construct is valid for a period equal to that of Improvement Permit – not to exceed sixty months.

Signed: date 10.30.01 Installed by: W. Christenbury RS

Improvement Permit by: KS date 10/29/01 Operation Permit by: date 7/29/03

Authorization to Construct by: KS date 10/29/01 Existing System Inspection by: date

Maria H. Dotson RS 4/25/03

HEALTH DEPT COPY: WHITE OWNER COPY (FINAL): YELLOW OWNER COPY (INITIAL): PINK