4:00

IREDELL COUNTY HEALTH DEPARTMENT

STATESVILLE 704-878-5305 MOORESVILLE 704-664-5281

IMPROVEMENT PERMIT / AUTHORIZATION TO CONSTRUCT / OPERATION PERMIT / EXISTING SYSTEM INSPECTION

PERMIT# 089107 PIN# 4669003656 (pt.) 4669-00-2807 DATE October 26, 00

OWNER OR CONTRACTOR Mike Kroon PHONE: Business 664-3671 Home

ADDRESS 149 Yacht Cove Ln. Mooresville

LOCATION 115 N. TR Shinnville TL Brookglen TL Rocky Point Attend on Right

SUBDIVISION Brookglen BLOCK / SECTION 1 LOT 42 LOT AREA 1.4Ac SITE CLASS PS DESIGN FLOW 360gpd L.T.A.R. .03+

Septic Tank: 1000 Gallons; STB 312 Date 7-3-99
Pump Tank: 1000 Gallons; PT 283 Date 4-29-01
Pump Make: Hydromatic Model SK50A1 Serial No. 516541-02-7
Nitrification Field: No Fields 1 Square Feet 900 Linear Feet 300
No Lines 3 Trench Width 36" Max Trench Bottom Depth 36" Gravel Depth N/A

☑ New System ☐ Repair System Type: I, II, III, IV, V, VI
System Description: PM – Innovative 25% Red
Repair System Description: Same
Maintenance Agreement Required: ☐ Yes ☑ No


☑ House/Mod. Home No. Bedrooms 3
☐ Mobile Home No. Bathrooms 2
☐ Business No. Employees
☐ Other
☐ Slab ☑ Crawl Space ☑ Basement w/plumbing ☐ Basement wo/plumbing

Water Supply: ☑ Individual ☐ Public ☐ Community

Comments/Conditions: Maintain 100' minimum between well & septic system.

Comments/Conditions: ~~PARTIAL~~ PARTIAL Check tanks 6/15/2001 No filter installed yet. Check lines 6/15/2001 Pressure Checked 6/19/2001

INITIAL SITE SKETCH 1"=50'

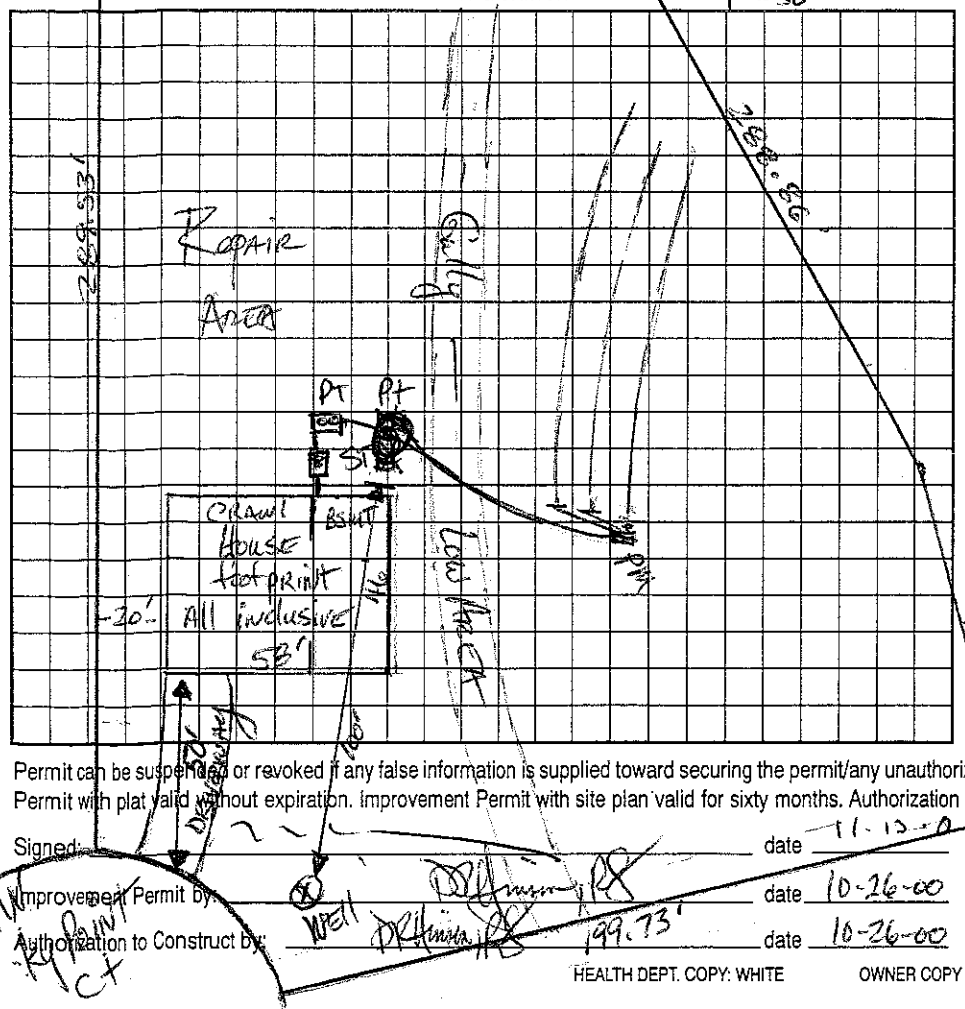

AS BUILT SKETCH

EZ Flow Drainlines installed as drawn

Permit can be suspended or revoked if any false information is supplied toward securing the permit/any unauthorized changes are made to the site/any unauthorized changes are made in the installation of the system. Improvement Permit with plat valid without expiration. Improvement Permit with site plan valid for sixty months. Authorization to Construct is valid for a period equal to that of Improvement Permit – not to exceed sixty months.

Signed: date 11-15-00 Installed by: Tommy Frye

Improvement Permit by: date 10-26-00 Operation Permit by: Wesley Sparks date 6/29/01

Authorization to Construct by: date 10-26-00 Existing System Inspection by: date

HEALTH DEPT. COPY: WHITE OWNER COPY (FINAL): YELLOW OWNER COPY (INITIAL): PINK