IREDELL COUNTY HEALTH DEPARTMENT

STATESVILLE 704-878-5305 MOORESVILLE 704-664-5281

IMPROVEMENT PERMIT / AUTHORIZATION TO CONSTRUCT / OPERATION PERMIT / EXISTING SYSTEM INSPECTION

PERMIT# 089110 PIN# ~~4669~~00369676 PT 4669-00-3454 DATE 10/31/01

OWNER OR CONTRACTOR KES INVESTMENTS / R.W. ROWE PHONE: Business 664-3671 Home

ADDRESS 149 YACHT COVE LN MOORESVILLE NC 28115

LOCATION 115 N - TR SHANNVILLE RD - TL BROOKGLEN - TL ROCKY POINT - ON RT

SUBDIVISION BROOKGLEN BLOCK / SECTION 1 LOT 45 LOT AREA .97AC SITE CLASS. PS DESIGN FLOW 360GPD L.T.A.R. .36GPD/FT

Septic Tank: 1000 Gallons; STB 1012 Date 3-8-02

Pump Tank: Gallons; PT Date

Pump Make: Model Serial No.

Nitrification Field: No Fields 1 Square Feet 1200 Linear Feet 400

No Lines 4@100' Trench Width 36" Max Trench Bottom Depth 36" Gravel Depth 12"

☑ New System ☐ Repair System Type: I (II) III, IV, V, VI

System Description: GRAVITY CONVENTIONAL

Repair System Description: GRAV. ~~[illegible]~~ INNOVATIVE

Maintenance Agreement Required: ☐ Yes ☑ No

☑ House/Mod. Home No. Bedrooms 3

☐ Mobile Home No. Bathrooms 3

☐ Business No. Employees

☐ Other


☐ Slab ☑ Crawl Space ☐ Basement w/plumbing ☐ Basement wo/plumbing

Water Supply: ☑ Individual ☐ Public ☐ Community

Comments:/Conditions:

Comments:/Conditions:

INITIAL SITE SKETCH 1"=50'

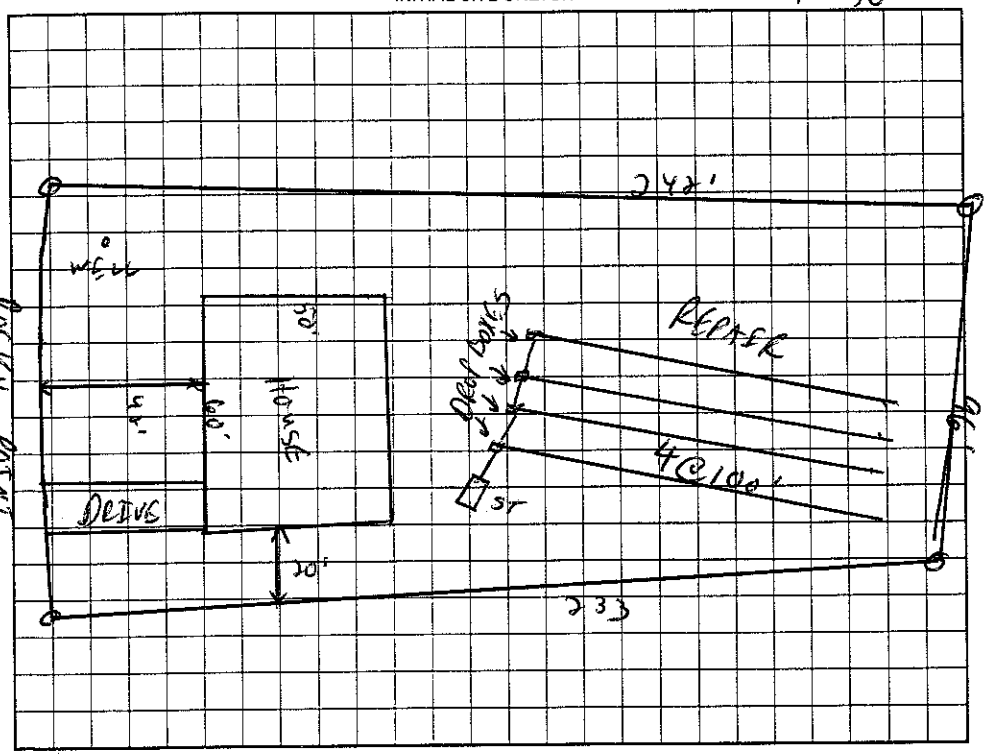

AS BUILT SKETCH

Installed As Drawn

Permit can be suspended or revoked if any false information is supplied toward securing the permit/any unauthorized changes are made to the site/any unauthorized changes are made in the installation of the system. Improvement Permit with plat valid without expiration. Improvement Permit with site plan valid for sixty months. Authorization to Construct is valid for a period equal to that of Improvement Permit – not to exceed sixty months.

Signed: date 11-6-01

Improvement Permit by: C. Sykes RS date 10/31/01

Authorization to Construct by: C. Sykes RS date 3/5/02

Installed by: Tommy Fryar RS

Operation Permit by: [signature] date 7/23/2002

Existing System Inspection by: date

HEALTH DEPT. COPY: WHITE OWNER COPY (FINAL): YELLOW OWNER COPY (INITIAL): PINK