# IREDELL COUNTY HEALTH DEPARTMENT

STATESVILLE 704-878-5305 MOORESVILLE 704-664-5281

## IMPROVEMENT PERMIT / AUTHORIZATION TO CONSTRUCT / OPERATION PERMIT / EXISTING SYSTEM INSPECTION

PERMIT# 08926 7 PIN# ~~4669-00-3656 PT~~ 4669-00-4137 DATE 10/31/01

OWNER OR CONTRACTOR KFS INVESTMENTS / Lyle E. Calkins PHONE: Business 664-3671 Home

ADDRESS 14a YACHT COVE LN MOORESVILLE

LOCATION 115 N- TR SHINNVILLE - TL BROOKGLEN- TL ROCKY PT- ON RT

SUBDIVISION BROOKGLEN BLOCK / SECTION 1 LOT 47 LOT AREA .624c SITE CLASS. PS DESIGN FLOW 360GPD L.T.A.R. .36PP/FT²

Septic Tank: 1000 Gallons; STB 317 Date 3-2-03
Pump Tank: Gallons; PT Date
Pump Make: Model Serial No.
Nitrification Field: No Fields 1 Square Feet 900 Linear Feet 300
No Lines 3@100' Trench Width 36" Max Trench Bottom Depth 36" Gravel Depth N/A

☑ New System ☐ Repair System Type: I, II, (III), IV, V, VI
System Description: GRAVITY INNOVATIVE
Repair System Description: PUMP PANEL
Maintenance Agreement Required: ☐ Yes ☑ No


☑ House/Mod. Home No. Bedrooms 3
☐ Mobile Home No. Bathrooms 3
☐ Business No. Employees
☐ Other
☐ Slab ☑ Crawl Space ☐ Basement w/plumbing ☐ Basement wo/plumbing

Water Supply: ☑ Individual ☐ Public ☐ Community

Comments:/Conditions: KEEP WELL 100' FROM SYSTEM

Comments:/Conditions: Grey filter installed

INITIAL SITE SKETCH 1" = 50'

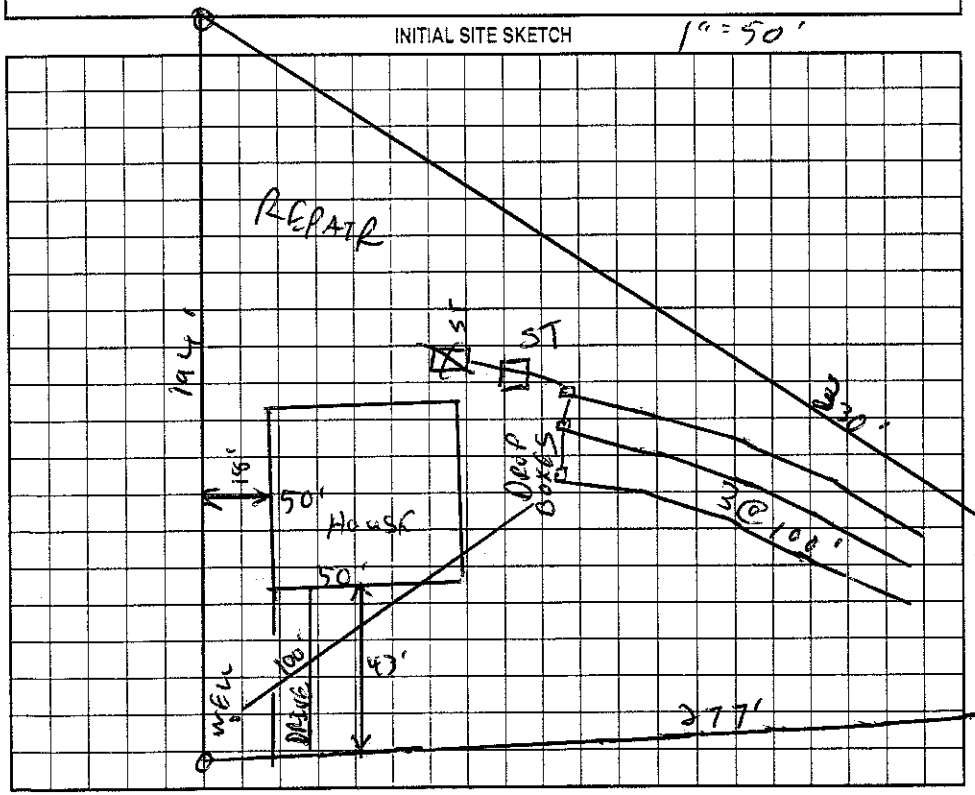


AS BUILT SKETCH

Installed EZ Flow lines
Used Distribution box

Permit can be suspended or revoked if any false information is supplied toward securing the permit/any unauthorized changes are made to the site/any unauthorized changes are made in the installation of the system. Improvement Permit with plat valid without expiration. Improvement Permit with site plan valid for sixty months. Authorization to Construct is valid for a period equal to that of Improvement Permit – not to exceed sixty months.

Signed: date 11.6.01 Installed by: B.W. Christenbury

Improvement Permit by: RS date 10/31/01 Operation Permit by: Maint. Loan RS date

Authorization to Construct by: RS date 2/4/03 Existing System Inspection by: date

HEALTH DEPT. COPY: WHITE OWNER COPY (FINAL): YELLOW OWNER COPY (INITIAL): PINK