3:00

IREDELL COUNTY HEALTH DEPARTMENT

STATESVILLE 704-878-5305 MOORESVILLE 704-664-5281

IMPROVEMENT PERMIT / AUTHORIZATION TO CONSTRUCT / OPERATION PERMIT / EXISTING SYSTEM INSPECTION

PERMIT# 089491 PIN# ~~4696900365 6 AT~~ 4696900478 8 DATE 11/1/01

OWNER OR CONTRACTOR MFS INVESTMENTS / Calkins Construction PHONE: Business 664-3671 Home

ADDRESS 149 YACHT COVE LN · MOORESVILLE · NC 28115

LOCATION 115 N- TR SHENNVILLE - TL BROOKGLEN - ON LT

SUBDIVISION BROOKGLEN BLOCK / SECTION 1 LOT 55 LOT AREA .57 AC SITE CLASS. PS DESIGN FLOW 360 GPD L.T.A.R. .36 PD/FT

Septic Tank: 1000 Gallons; STB 283 Date 6-2-04

Pump Tank: 1000 Gallons; PT 312 Date 2-28-05

Pump Make: Zoeller Model 152 Serial No.

Nitrification Field: No Fields 1 Square Feet 900 Linear Feet 300

No Lines 4@75' Trench Width 36" Max Trench Bottom Depth 36" Gravel Depth N/A

☑ New System ☐ Repair System Type: I, II, III, IV, V, VI

System Description: PUMP 25% REDUCTION

Repair System Description: LPP PANEL

Maintenance Agreement Required: ☐ Yes ☑ No

☑ House/Mod. Home No. Bedrooms 3

☐ Mobile Home No. Bathrooms 3

☐ Business No. Employees

☐ Other


☐ Slab ☑ Crawl Space ☐ Basement w/plumbing ☐ Basement wo/plumbing

Water Supply: ☑ Individual ☐ Public ☐ Community

Comments:/Conditions: ~~*~~Drive on other side
Reviewed Building plans 1/3/05 in compliance with original permit

Comments:/Conditions: Checked tanks & lines 4/21/05
Checked pressure, elect. & alarm 4/25/05

INITIAL SITE SKETCH 1"=50'

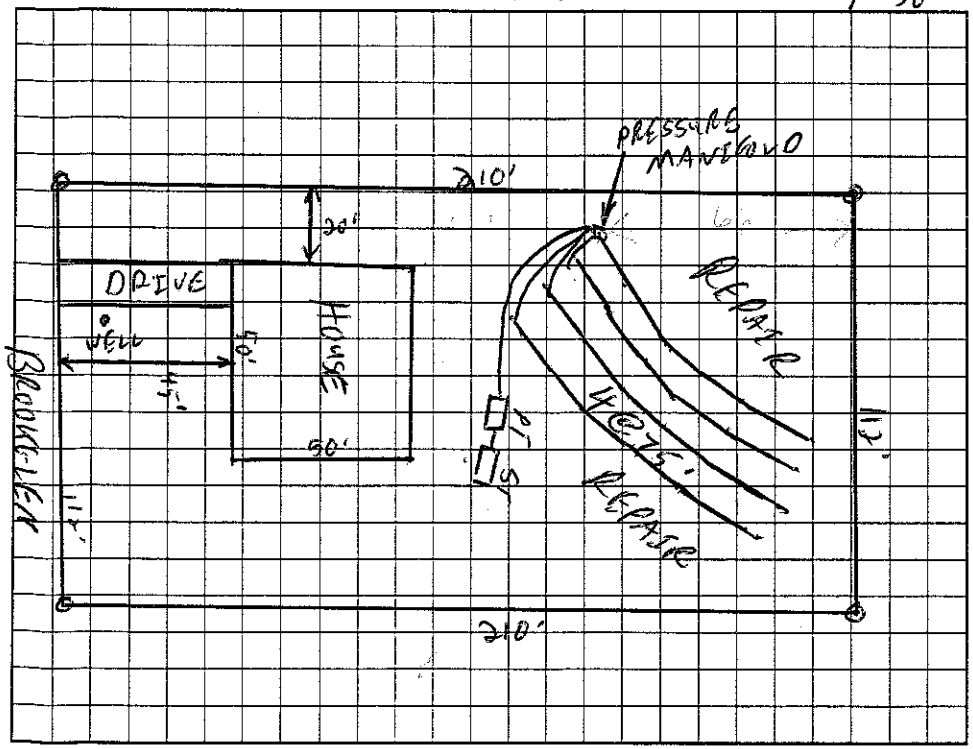

AS BUILT SKETCH

Permit can be suspended or revoked if any false information is supplied toward securing the permit/any unauthorized changes are made to the site/any unauthorized changes are made in the installation of the system. Improvement Permit with plat valid without expiration. Improvement Permit with site plan valid for sixty months. Authorization to Construct is valid for a period equal to that of Improvement Permit – not to exceed sixty months.

Signed: ~~~ date 11-6-01

Improvement Permit by: [signature] date 11/1/01

Authorization to Construct by: [signature] date 11/3/05

Installed by: Willie Christenbury

Operation Permit by: [signature] date 4/25/05

Existing System Inspection by: date

HEALTH DEPT. COPY: WHITE OWNER COPY (FINAL): YELLOW OWNER COPY (INITIAL): PINK