1338601

IREDELL COUNTY HEALTH DEPARTMENT

STATESVILLE 704-878-5305 MOORESVILLE 704-664-5281

IMPROVEMENT PERMIT / AUTHORIZATION TO CONSTRUCT / OPERATION PERMIT / EXISTING SYSTEM INSPECTION

PERMIT# 08 9168 PIN# 4669903656 PT 4669005566 DATE 11/1/01

OWNER OR CONTRACTOR KFS INVESTMENTS/Lexus Homes PHONE: Business 664-3671 Home

ADDRESS 149 YACHT COVE LN MOORESVILLE N.C. 28115

LOCATION 115N - TR SHINNVILLE - TL BROOKGLEN - ON LT #163

SUBDIVISION BROOKGLEN BLOCK / SECTION LOT 53 LOT AREA .55AC SITE CLASS. RS DESIGN FLOW 360GPD L.T.A.R. .30-PD/F12

Septic Tank: 1000 Gallons; STB 312 Date 4-12-06

Pump Tank: 1000 Gallons; PT 3283 Date 4-16-06

Pump Make: Model NIST Serial No.

Nitrification Field: No Fields 1 Square Feet 900 Linear Feet 300

No Lines 3 Trench Width 36" Max Trench Bottom Depth 36" Gravel Depth N/A

☑ New System ☐ Repair System Type: I, II, III, IV, V, VI

System Description: PUMP 25% REDUCTION

Repair System Description: LP PANEL

Maintenance Agreement Required: ☐ Yes ☑ No

☑ House/Mod. Home No. Bedrooms 3

☐ Mobile Home No. Bathrooms 3

☐ Business No. Employees

☐ Other

☐ Slab ☑ Crawl Space ☐ Basement w/plumbing ☐ Basement wo/plumbing

Water Supply: ☑ Individual ☐ Public ☐ Community

Comments:/Conditions: Reviewed Building plans, in Compliance with orignal permit.


Comments:/Conditions: Tanks checked 6/8/06 MD

Lines checked & pressure 6/12/06 AWS

8-1B supply line to pm broken.

8-21-06 line fixed - pressure head checked JM

INITIAL SITE SKETCH 1" = 50'

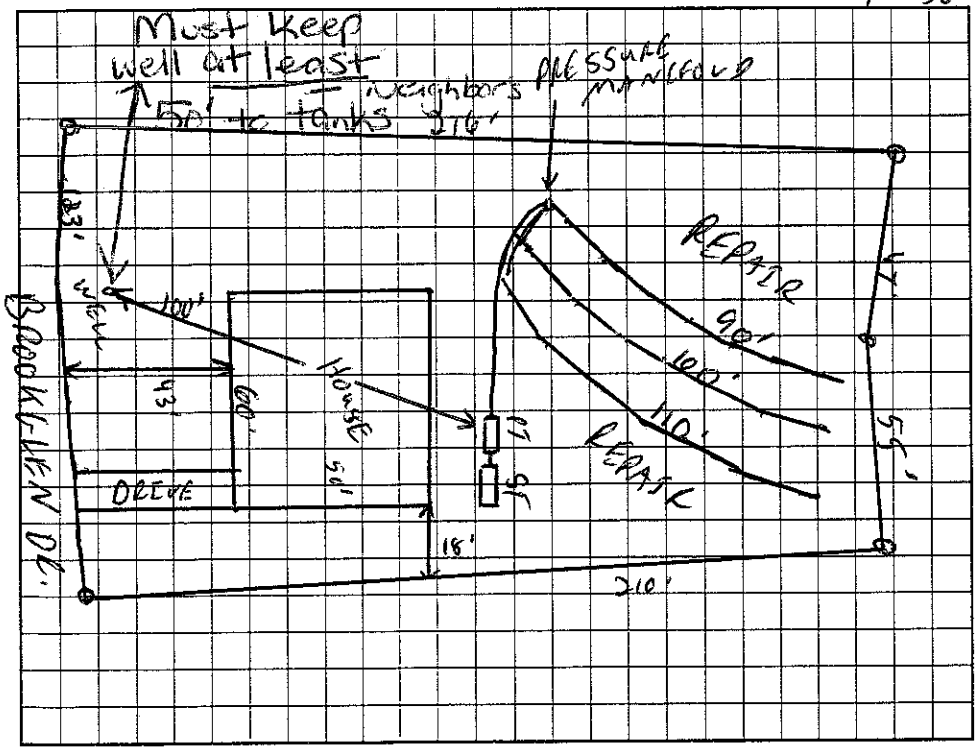

AS BUILT SKETCH

Permit can be suspended or revoked if any false information is supplied toward securing the permit/any unauthorized changes are made to the site/any unauthorized changes are made in the installation of the system. Improvement Permit with plat valid without expiration. Improvement Permit with site plan valid for sixty months. Authorization to Construct is valid for a period equal to that of Improvement Permit – not to exceed sixty months.

Signed: date 11.6.01 Installed by: Willie Christenbury

Improvement Permit by: C. date 11/1/01 Operation Permit by: date 8-21-06

Authorization to Construct by: RS 2/9/06 Existing System Inspection by: date

HEALTH DEPT. COPY: WHITE OWNER COPY (FINAL): YELLOW OWNER COPY (INITIAL): PINK