IREDELL COUNTY HEALTH DEPARTMENT

STATESVILLE 704-878-5305 125.00 Paid start 12:00 MOORESVILLE 704-664-5281

IMPROVEMENT PERMIT / AUTHORIZATION TO CONSTRUCT / OPERATION PERMIT / EXISTING SYSTEM INSPECTIO

PERMIT# 08916 / 115857 PIN# 4669003656 PT 4669005627 DATE 12/5/01

OWNER OR CONTRACTOR KFS INVESTMENTS / ES JOHNSON BUILDERS PHONE: Business 664-3671 Home

ADDRESS 149 YACHT COVE LN MOORESVILLE NC 28115

LOCATION 21N - TL SHINNVILLE - TL BROOKGLEN - ON LT

SUBDIVISION BROOKGLEN BLOCK / SECTION LOT 54 LOT AREA .5 AC SITE CLASS. RS DESIGN FLOW 360GPD L.T.A.R. .36 RP / ET

Septic Tank: 1000 Gallons; STB Date 10-25-03

Pump Tank: 1000 Gallons; PT Date 11-6-03

Pump Make: Zoeller Model Serial No.

Nitrification Field: No Fields 1 Square Feet 900 Linear Feet 300

No Lines 4@75' Trench Width 36" Max Trench Bottom Depth 36" Gravel Depth N/A

☑ New System ☐ Repair System Type: I, II, III, IV, V, VI

System Description: PUMP 25% REDUCTION

Repair System Description: LP PANEL

Maintenance Agreement Required: ☐ Yes ☑ No

☑ House/Mod. Home No. Bedrooms 3

☐ Mobile Home No. Bathrooms 3

☐ Business No. Employees

☐ Other


☐ Slab ☑ Crawl Space ☐ Basement w/plumbing ☐ Basement wo/plumbing

Water Supply: ☑ Individual ☐ Public ☐ Community

Comments:/Conditions: DRIVE ON OPPOSITE SIDE

Comments:/Conditions: Checked tanks, lines & pressure 1/13/04 mz

INITIAL SITE SKETCH 1" = 50'

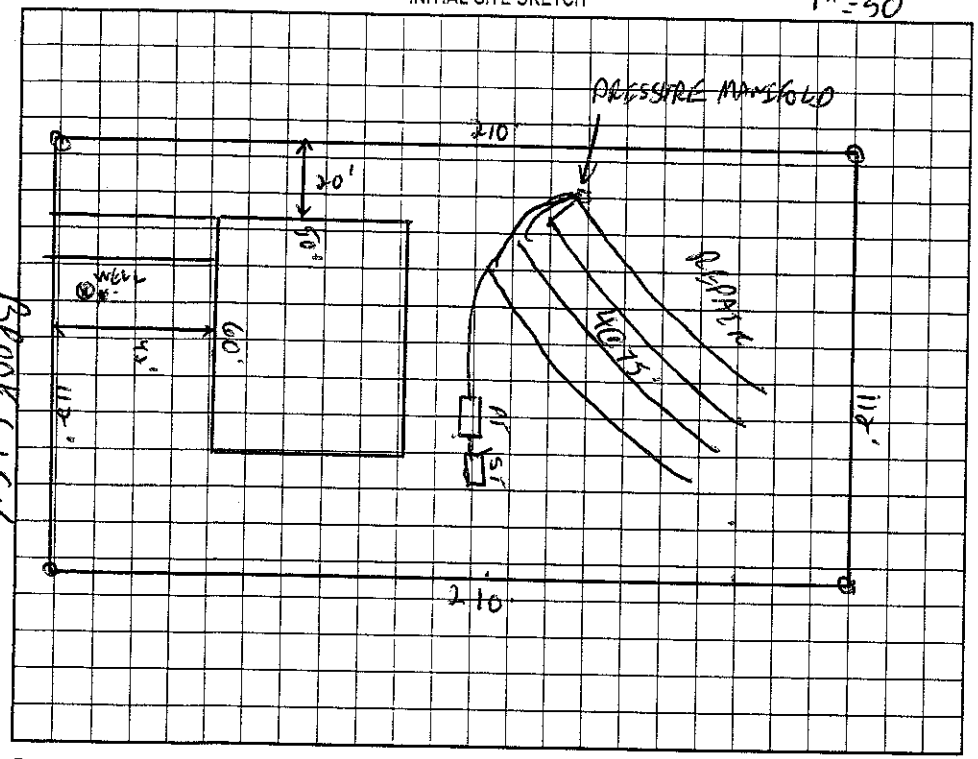

AS BUILT SKETCH

Installed EZ Flow as Drawn

Permit can be suspended or revoked if any false information is supplied toward securing the permit/any unauthorized changes are made to the site/any unauthorized changes are made in the installation of the system. Improvement Permit with plat valid without expiration. Improvement Permit with site plan valid for sixty months. Authorization to Construct is valid for a period equal to that of Improvement Permit – not to exceed sixty months.

Signed: date 12.06.01 Installed by: Willie Christenbury

Improvement Permit by: RS date 12/5/01 Operation Permit by: Wesley Sparks RS date 4/6/04

Authorization to Construct by: RS date 9/5/03 Existing System Inspection by: date

HEALTH DEPT. COPY: WHITE OWNER COPY (FINAL): YELLOW OWNER COPY (INITIAL): PINK