4:00

IREDELL COUNTY HEALTH DEPARTMENT

STATESVILLE 704-878-5305 MOORESVILLE 704-664-5281

IMPROVEMENT PERMIT / AUTHORIZATION TO CONSTRUCT / OPERATION PERMIT / EXISTING SYSTEM INSPECTION

PERMIT# 84153 PIN# 4664003656 PT 4669-00-8041 DATE 1/30/01

OWNER OR CONTRACTOR KFS INVESTMENTS PHONE: Business 664-3671 Home

ADDRESS 149 YACHT COVE LN MOORESVILLE

LOCATION 115 N - TR STATESVILLE - TL BROOKGLEN - ON RT -

SUBDIVISION BROOKGLEN BLOCK / SECTION 1 LOT 9 LOT AREA 1.05AC SITE CLASS. PS DESIGN FLOW 360GPD L.T.A.R. .30 PD/FT²

Septic Tank: 1000 Gallons; STB 1012 Date 6-25-01

Pump Tank: 1000 Gallons; PT 17 Date 10-13-00

Pump Make: Goulds Model WE05511H Serial No. H015534

Nitrification Field: No Fields 1 Square Feet 1200 Linear Feet 400

No Lines 4@100' Trench Width 36" Max Trench Bottom Depth 36" Gravel Depth 12"

☑ New System ☐ Repair System Type: I, II, III, IV, V, VI

System Description: PUMP CONVENTIONAL

Repair System Description: SAME/INNOVATIVE

Maintenance Agreement Required: ☐ Yes ☑ No

☑ House/Mod. Home No. Bedrooms 3

☐ Mobile Home No. Bathrooms 2

☐ Business No. Employees


☐ Other

☐ Slab ☑ Crawl Space ☐ Basement w/plumbing ☐ Basement wo/plumbing

Water Supply: ☑ Individual ☐ Public ☐ Community

Comments:/Conditions: 1) KEEP WELL 100' FROM SYSTEM AND REPAIR. (LOT 9 & 10 COMBINED)

INITIAL SITE SKETCH

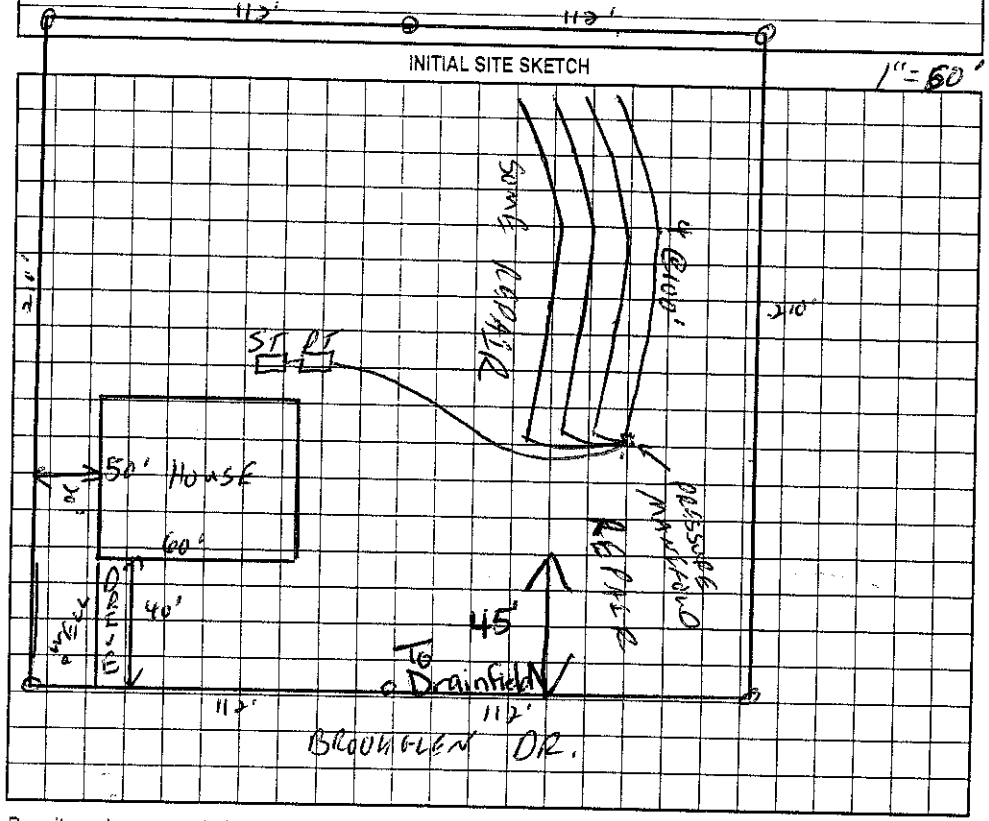

Comments:/Conditions:

4-12-01 - Reviewed Hearnplow; appears in compliance w/ I.P. Pres. checked 4/19/2001 MF

Checked tanks & Drainfield 4/18/2001 MF

AS BUILT SKETCH

Installed Conv. Drainfield

Location of the proposed SHOP addition does not appear to impact the existing on-site septic system.**NOTE:

REHS

Date: 1-9-12

ICHD-Environmental Health Division

GREASE TRAP REQUIRED BY STATE (DENR) PERMIT TO BE ISSUED BY DENR

APPROVAL FOR BUILDING LOCATION ONLY

Permit can be suspended or revoked if any false information is supplied toward securing the permit/any unauthorized changes are made to the site/any unauthorized changes are made in the installation of the system. Improvement Permit with plat valid without expiration. Improvement Permit with site plan valid for sixty months. Authorization to Construct is valid for a period equal to that of Improvement Permit – not to exceed sixty months.

Signed: date 4.11.01

Improvement Permit by: C. B. Tayman RS date 1/30/01

Authorization to Construct by: Mark R. Hearnplow, RS date 4-12-01

Installed by: Tommy Frye

Operation Permit by RSJ date 10/2/01

Existing System Inspection by: date

HEALTH DEPT. COPY: WHITE OWNER COPY (FINAL): YELLOW OWNER COPY (INITIAL): PINK