# IREDELL COUNTY HEALTH DEPARTMENT

STATESVILLE 704-878-5305 125.00 Paid MOORESVILLE 704-664-5281

## IMPROVEMENT PERMIT / AUTHORIZATION TO CONSTRUCT / OPERATION PERMIT / EXISTING SYSTEM INSPECT

PERMIT# 088997 PIN# 4669003656 (pt) 4669-01-3364 DATE April 26, 01

OWNER OR CONTRACTOR Mike Krom PHONE: Business Home

ADDRESS 149 Yacht Cove Ln Mooresville NC 28115

LOCATION 115-21 N TR Shinnville Rd. TL BrookGlen last Lot on Right before creek

SUBDIVISION BrookGlen BLOCK / SECTION 1 LOT 26 LOT AREA 1.29ac SITE CLASS. RS DESIGN FLOW 360gpd L.T.A.R. .03

Septic Tank: 1000 Gallons; STB 1012 Date 4/8/01

Pump Tank: 1000 Gallons; PT 17 Date 10/2/01

Geomatrix EQ1B667 Model WEO512H Serial No.

Nitrification Field: No Fields 1 Square Feet 900 Linear Feet 300

No Lines 3 Trench Width 36" Max Trench Bottom Depth 36" Gravel Depth NA

☑ New System ☐ Repair System Type: I, II, III, IV, V, VI

System Description: PM-Innovative -25% Red

Repair System Description: LP/PM PPBPS

Maintenance Agreement Required: ☐ Yes ☑ No

☑ House/Mod. Home No. Bedrooms 3

☐ Mobile Home No. Bathrooms 2

☐ Business No. Employees

☐ Other


☐ Slab ☐ Crawl Space ☐ Basement w/plumbing ☑ Basement wo/plumbing

Water Supply: ☑ Individual ☐ Public ☐ Community


Comments:/Conditions:

Comments:/Conditions: Pressure Checked 8/27/01
Electr Alarm ok. 10/9/01

INITIAL SITE SKETCH

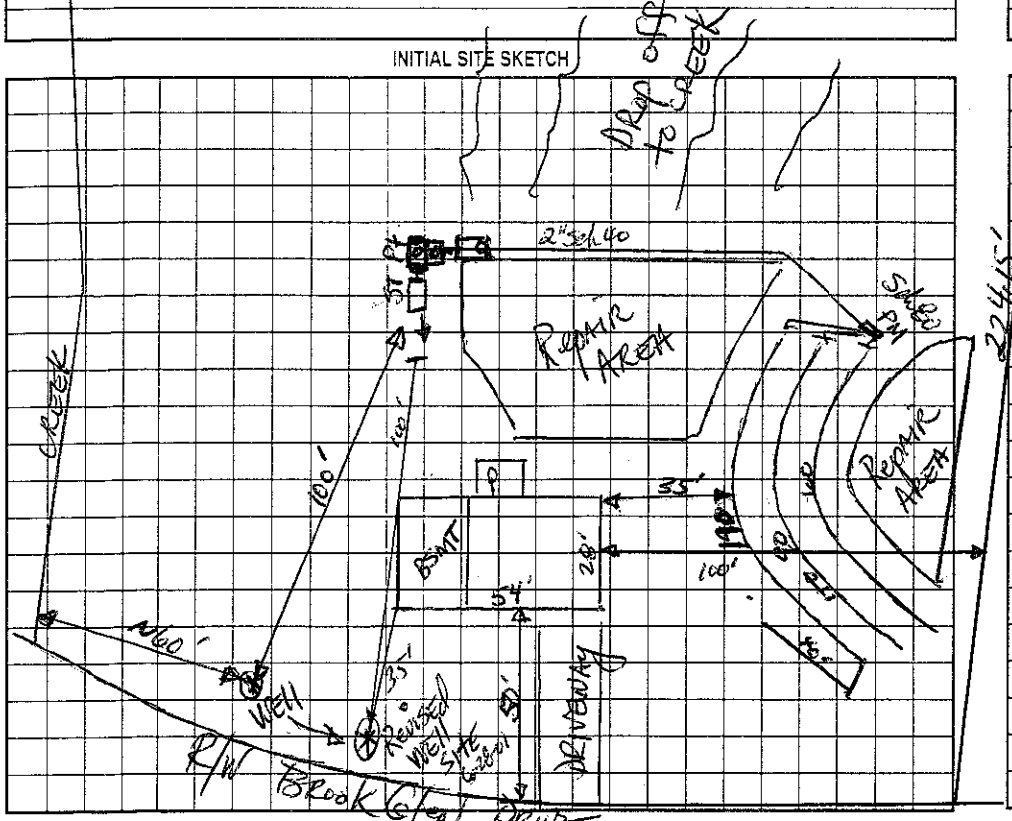


AS BUILT SKETCH

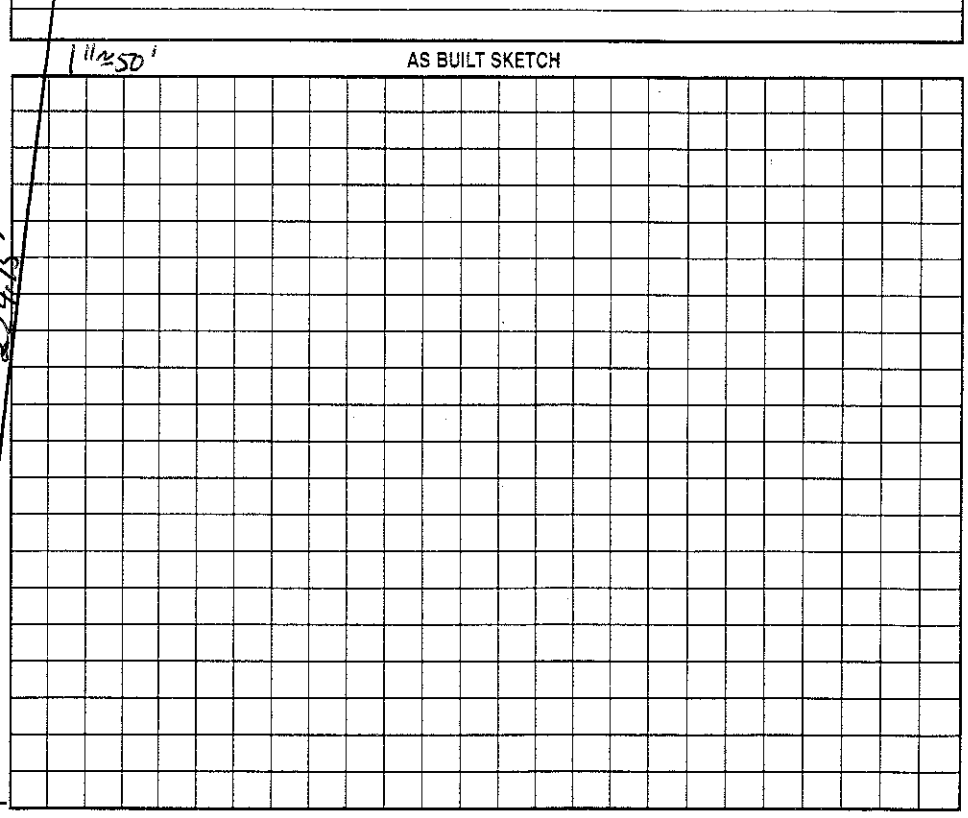


Permit can be suspended or revoked if any false information is supplied toward securing the permit/any unauthorized changes are made to the site/any unauthorized changes are made in the installation of the system. Improvement Permit with plat valid without expiration. Improvement Permit with site plan valid for sixty months. Authorization to Construct is valid for a period equal to that of Improvement Permit - not to exceed sixty months.

Signed: date 4.27.01 Installed by: Tommy Fagg RS

Improvement Permit by: RS date 4-26-01 Operation Permit by: Maria W.H. date 10/9/2001

Authorization to Construct by: RS date 4-26-01 Existing System Inspection by: date

HEALTH DEPT. COPY: WHITE OWNER COPY (FINAL): YELLOW OWNER COPY (INITIAL): PINK