185 Albany Dr.

3:30

# IREDELL COUNTY HEALTH DEPARTMENT

STATESVILLE 704-878-5305 MOORESVILLE 704-664-5281

## IMPROVEMENT PERMIT / AUTHORIZATION TO CONSTRUCT / OPERATION PERMIT / EXISTING SYSTEM INSPECTION

PERMIT# 142625 205163 PIN# ~~4669111776 004~~ 4669014664 DATE 6-6-07

OWNER OR APPLICANT Gaxon Martinez PHONE: Business Home

ADDRESS 1607 High Rock Rd Stanley NC 28164 185 Bethany Place

LOCATION 115/21 N on Shiloville Rd ≈ 1 mile from Albany at end on left

SUBDIVISION Bethany Place BLOCK / SECTION — LOT 9 LOT AREA 1.07 Acre SITE CLASS. PS DESIGN FLOW 480 L.T.A.R. .59

Septic Tank: 1000 Gallons: STB 1160 Date 12-5-14
Pump Tank: Gallons: PT Date
Pump Make: Model Serial No.
Nitrification Field: No Fields 1 Square Feet 1200 Linear Feet 400
No Lines 4@100' Trench Width 36" Max Trench Bottom Depth 36" Gravel Depth —

☒ New System ☐ Repair ☐ Expansion System Type: ☒ I ☐ II ☐ III ☐ IV ☐ V ☐ VI
System Description: 25% Reduced
Repair System Description: SAME
Maintenance Agreement Required: ☐ Yes ☒ No

☒ Gravity ☐ Pressure ☐ Slab ☒ Crawl Space ☐ Basement w/plumbing ☐ Basement wo/plumbing

☒ House/Mod. Home No. Bedrooms 4
☐ Mobile Home No. Persons
☐ Business No. Employees
☐ Other


Water Supply: ☒ Individual ☐ Public ☐ Community

Comments:/Conditions: 1) Install Lines on Contour
2) Keep lines & tanks a minimum of 5 ft from house foundation & 10' min. from property lines


Comments:/Conditions: ST left to House Middle. Extra line added because 4th line was shortened due to Fill Drainlines end under Powerlines

1"=60' SCALE

INITIAL SITE SKETCH

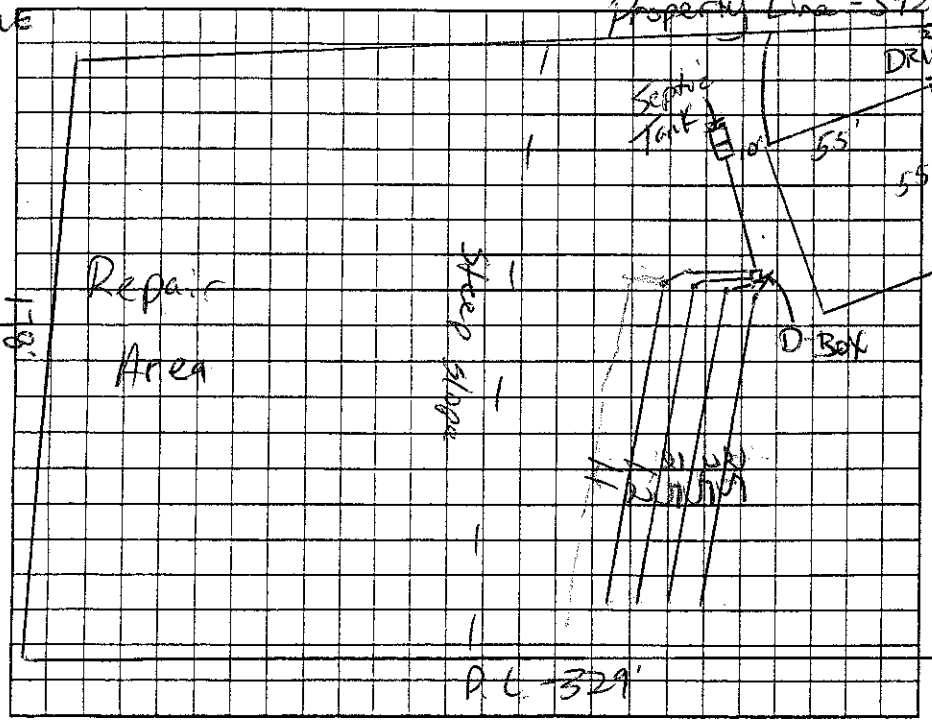


AS BUILT SKETCH

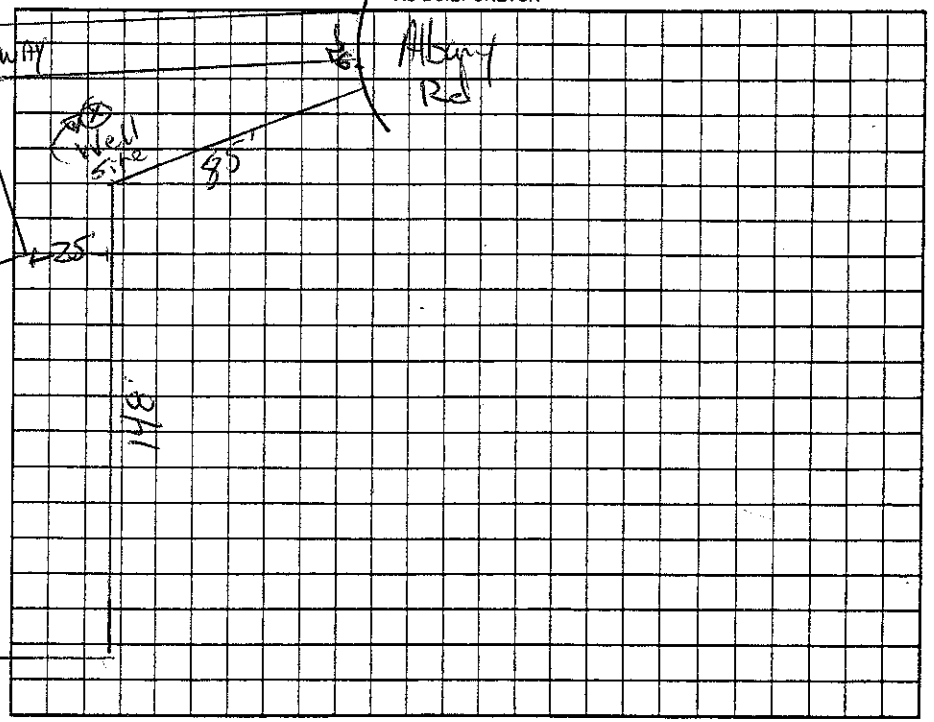


Permit can be suspended or revoked if any false information is supplied toward securing the permit/any unauthorized changes are made to the site/any unauthorized changes are made in the installation of the system. Improvement Permit with plat valid without expiration ☐ Improvement Permit with site plan valid for sixty months ☑ Authorization to Construct is valid for a period equal to that of Improvement Permit – not to exceed sixty months.

Signed: date Jun 11 07 Installed by: Cothren & Son RS

Improvement Permit by: Joseph E. Cayl date 6-7-07 Operation Permit by: Maria H. Dolan date 3/25/15

Authorization to Construct by: R. A. Ellis APPROVED SEP 02 2014 date Existing System Inspection by: date

HEALTH DEPT. COPY: WHITE OWNER COPY (FINAL): YELLOW OWNER COPY (INITIAL): PINK