IREDELL COUNTY HEALTH DEPARTMENT

STATESVILLE 704-878-5305 MOORESVILLE 704-664-5281

IMPROVEMENT PERMIT / AUTHORIZATION TO CONSTRUCT / OPERATION PERMIT / EXISTING SYSTEM INSPECTION

Paid 125.00 CK

PERMIT# 088996 PIN# ~~4669003656 (pt.)~~ 4669-01-5128 DATE September 22, 00

OWNER OR CONTRACTOR Mike Krom PHONE: Business 664-3671 Home

ADDRESS 149 Yacht Cove Ln. Mooresville

LOCATION 115 N. TR Shinnville Road TL Brookglen Drive TR Jennifer Way 1st lot on left

SUBDIVISION Brookglen BLOCK / SECTION 1 LOT 25 LOT AREA 1.34ac SITE CLASS 2S DESIGN FLOW 360gpd L.T.A.R. .3+

Septic Tank: 1000 Gallons; STB 1012 Date 10-28-2000
Pump Tank: Gallons; PT Date
Pump Make: Model Serial No.
Nitrification Field: No Fields 1 Square Feet 900 Linear Feet 300
No Lines 4 Trench Width 36" Max Trench Bottom Depth 36" Gravel Depth NK

☑ New System ☐ Repair System Type: I, II, III, IV, V, VI
System Description: Gravity Innovative -25% Reduction
Repair System Description: Same type
Maintenance Agreement Required: ☐ Yes ☑ No


☑ House/Mod. Home No. Bedrooms 3
☐ Mobile Home No. Bathrooms 2
☐ Business No. Employees
☐ Other
☑ Slab ☐ Crawl Space ☐ Basement w/plumbing ☐ Basement wo/plumbing

Water Supply: ☑ Individual ☐ Public ☐ Community

Comments/Conditions: EEEZZZ WAY may be best choice due to bending contour @ 100' minimum well/septic system separation. 2241

Comments/Conditions: Poly lok Filter installed EEEZZZ Way Drainlines installed Well not installed at time of inspection

INITIAL SITE SKETCH

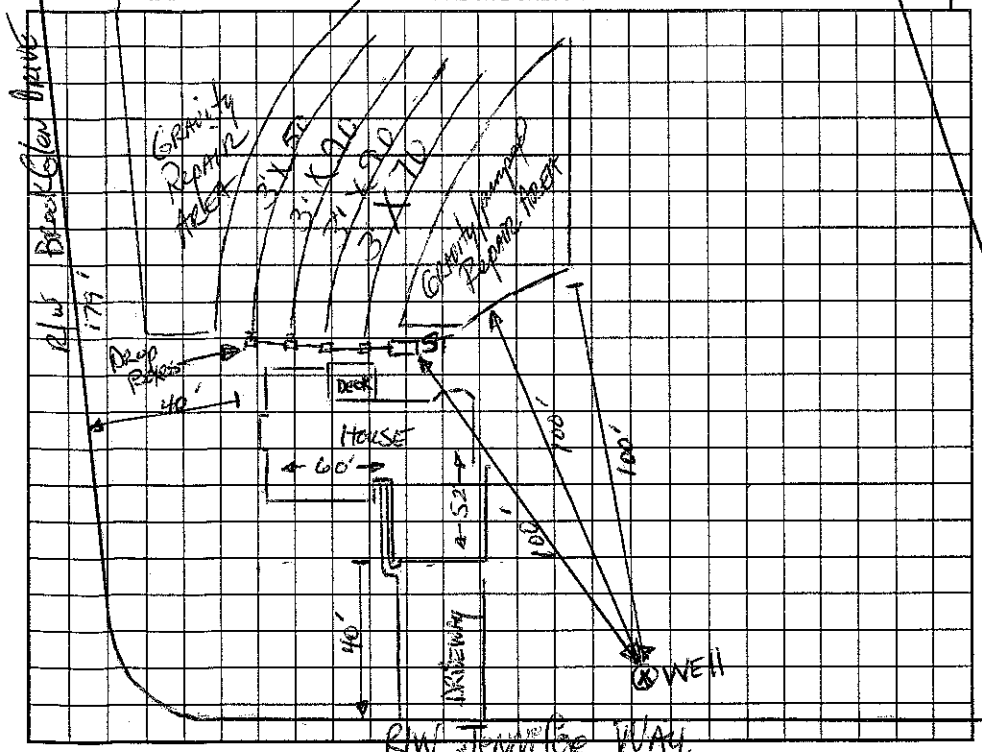

1"=50'

AS BUILT SKETCH

Permit can be suspended or revoked if any false information is supplied toward securing the permit/any unauthorized changes are made to the site/any unauthorized changes are made in the installation of the system. Improvement Permit with plat valid without expiration. Improvement Permit with site plan valid for sixty months. Authorization to Construct is valid for a period equal to that of Improvement Permit – not to exceed sixty months.

Signed: date 9-25-00 Installed by: Tommy Frye Grading

Improvement Permit by: Matt Hanson RS date 9-22-00 Operation Permit by: Mark H Gibson RS date 1/17/2001

Authorization to Construct by: Matt Hanson RS date 9-22-00 Existing System Inspection by: date

HEALTH DEPT. COPY: WHITE OWNER COPY (FINAL): YELLOW OWNER COPY (INITIAL): PINK