...EDELL COUNTY HEALTH DEPARTMENT

STATESVILLE 704-878-5305 MOORESVILLE 704-664-5281

IMPROVEMENT PERMIT / AUTHORIZATION TO CONSTRUCT / OPERATION PERMIT / EXISTING SYSTEM INSPECTION

DATE Jan 23, 01

PERMIT# 088995 PIN# 4669023656(pt)

OWNER OR CONTRACTOR Mike Kroon PHONE: Business 664-3671 Home

ADDRESS 149 Yacht Cove Lane, Mooresville, N.C. 28115

LOCATION 115-21 N TR Shearersville Rd TL BrookGlen Dr. TR Jennifer Way on left

SUBDIVISION BrookGlen BLOCK / SECTION 1 LOT 24 LOT AREA .9/Ac SITE CLASS. PS DESIGN FLOW 360gpd L.T.A.R. .3

Septic Tank: 1000 Gallons; STB 1012 Date 4/16/01

Pump Tank: Gallons; PT Date

Pump Make: Model Serial No.

Nitrification Field: No Fields 1 Square Feet 900 Linear Feet 300

No Lines 4 Trench Width 36" Max Trench Bottom Depth 36"

☑ New System ☐ Repair System Type: I, II, (III), IV, V, VI

System Description: Gravity Innovative 25% Red.

Repair System Description: Same

Maintenance Agreement Required: ☐ Yes ☑ No

Gravel Depth NA

☑ House/Mod. Home ☐ Mobile Home ☐ Business ☐ Other

No. Bedrooms 3 No. Bathrooms 2 No. Employees


☐ Slab ☑ Crawl Space ☐ Basement w/plumbing ☐ Basement wo/plumbing

Water Supply: ☑ Individual ☐ Public ☐ Community

Comments:/Conditions:

Comments:/Conditions:

INITIAL SITE SKETCH

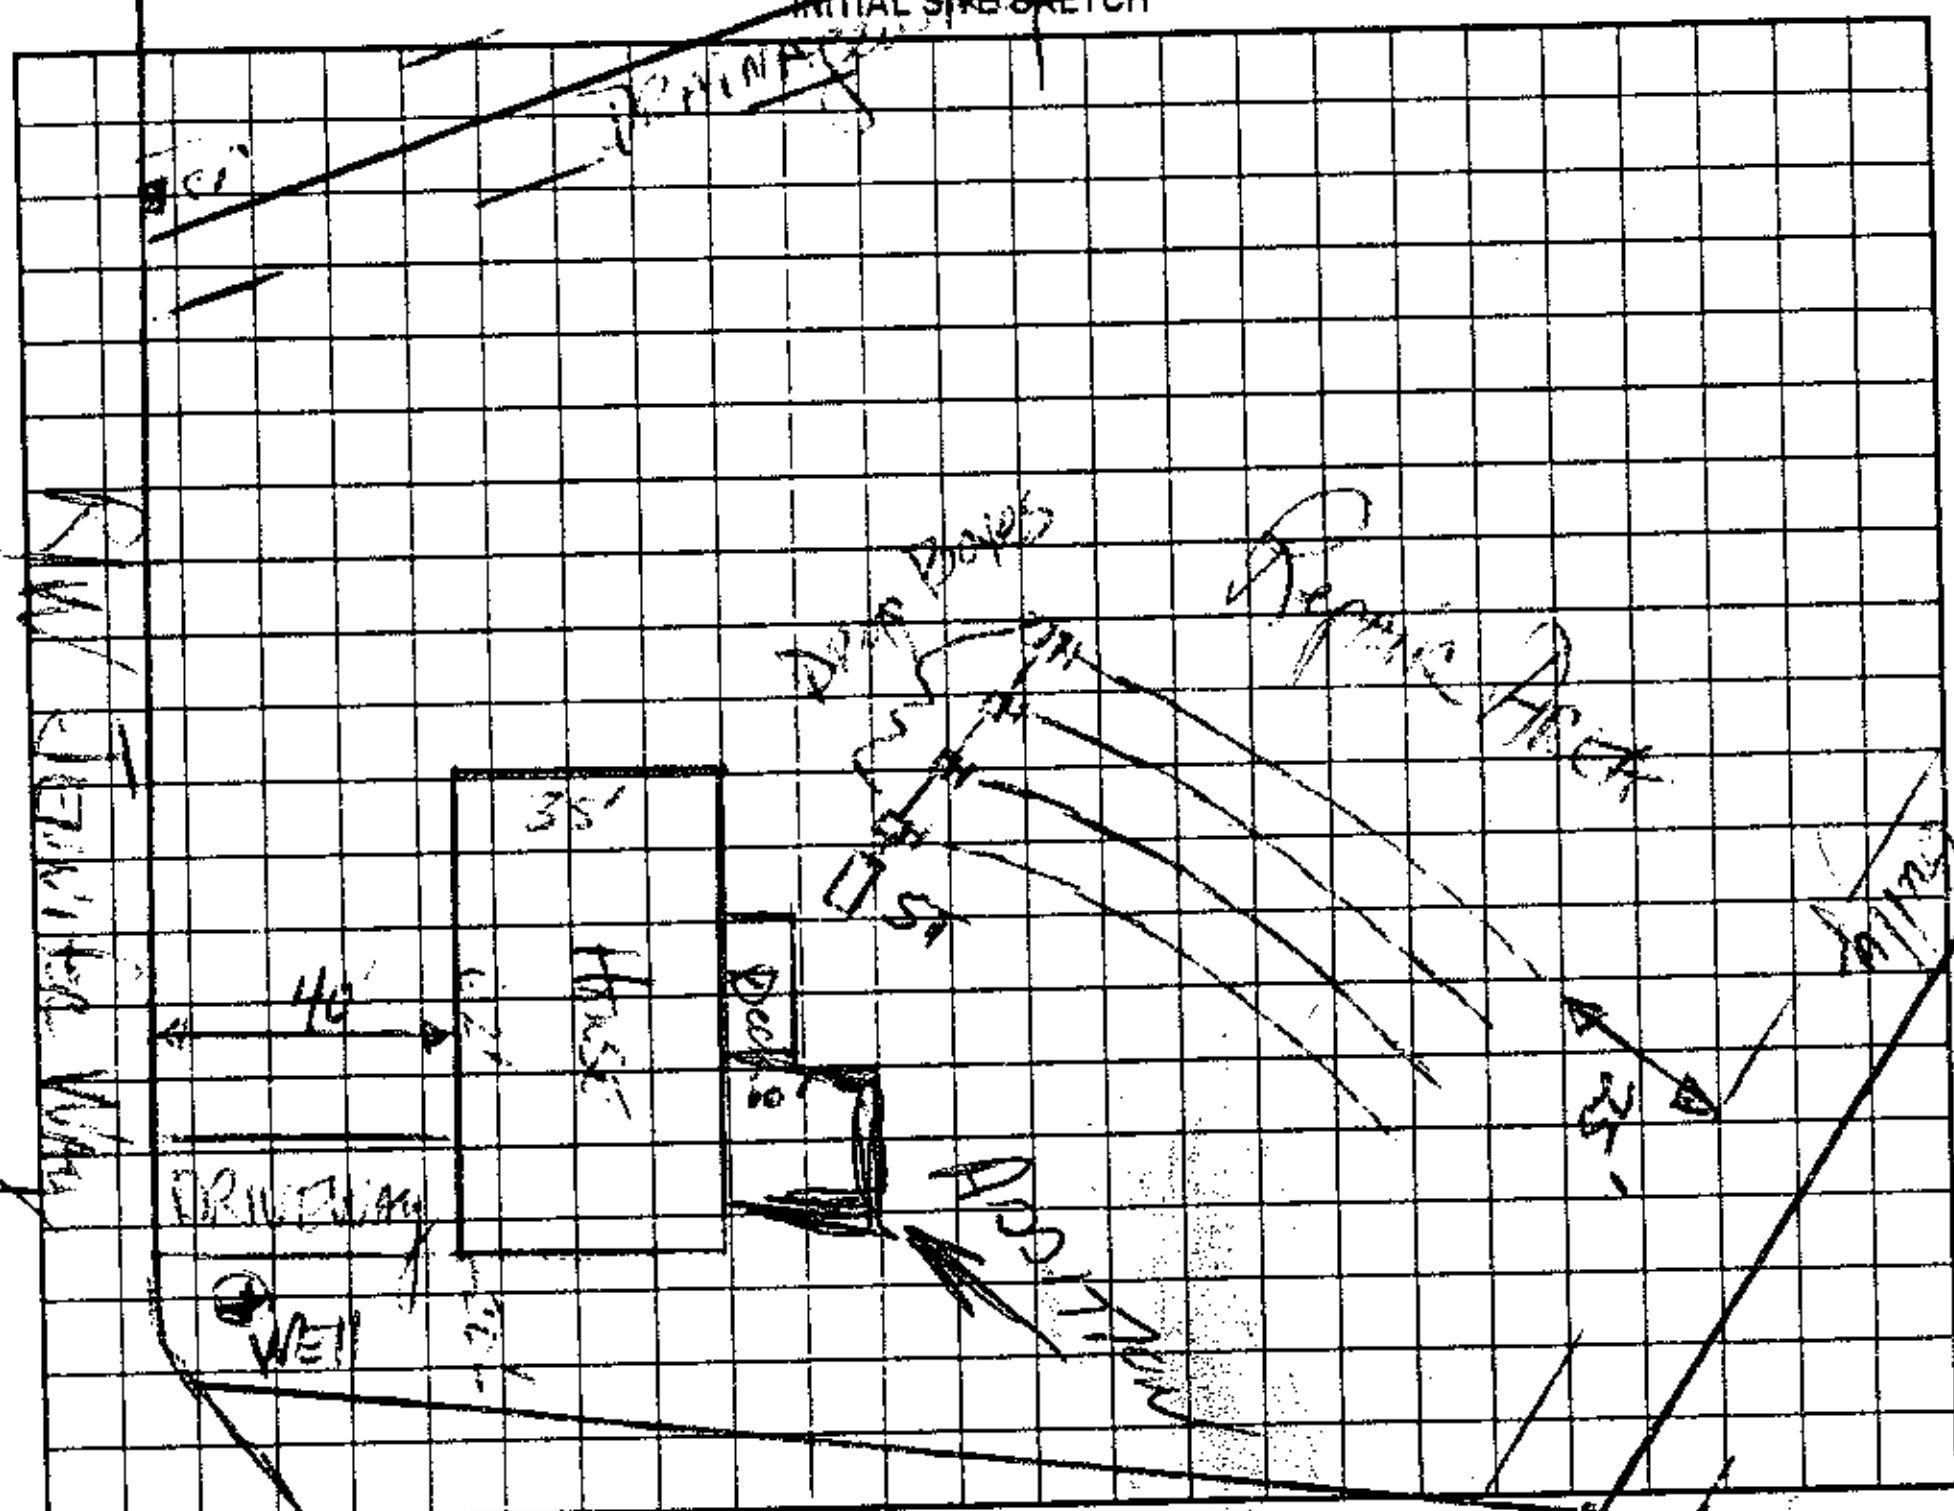

AS BUILT SKETCH

Permit can be suspended or revoked if any false information is supplied toward securing the permit/any unauthorized changes are made to the site/any unauthorized changes are made in the installation of the system. Improvement Permit with plat valid without expiration. Improvement Permit with site plan valid for sixty months. Authorization to Construct is valid for a period equal to that of Improvement Permit – not to exceed sixty months.

Signed: date 1-24-01

Improvement Permit by: [signature], RS date 1-23-01

Authorization to Construct by: [signature], RS date 1-23-01

Installed by: Tommy Frye

Operation Permit by: [signature] RSI date 7/12/01

Existing System Inspection by: date

HEALTH DEPT. COPY: WHITE OWNER COPY (FINAL): YELLOW OWNER COPY (INITIAL): PINK