IREDELL COUNTY HEALTH DEPARTMENT

Paid 125.00 2:00

STATESVILLE 704-878-5305 MOORESVILLE 704-664-5281

IMPROVEMENT PERMIT / AUTHORIZATION TO CONSTRUCT / OPERATION PERMIT / EXISTING SYSTEM INSPECTION

PERMIT# 088993 PIN# 4669003656 (pt.) 4669-01-9457 DATE October 23, 00

OWNER OR CONTRACTOR Mike Krom PHONE: Business 664-3671 Home

ADDRESS 149 Yacht Cove Ln. Mooresville N.C.

LOCATION I 115 N TR Shinnville TL Brookglen TR Jennifer Way Attend

SUBDIVISION Brookglen BLOCK / SECTION 1 LOT 22 LOT AREA .98Ac SITE CLASS. PS DESIGN FLOW 360gpd L.T.A.R. .3-.35

Septic Tank: 1000 Gallons; STB 194 Date 11-29-00
Pump Tank: 1000 Gallons; PT 27 Date 4-31-00
Pump Make: Goulds Model WE05H41 Serial No. M00048807
Nitrification Field: No Fields 1 Square Feet 1125 Linear Feet 375
No Lines 5 Trench Width 36" Max Trench Bottom Depth 36" Gravel Depth 12"

☑ New System ☐ Repair System Type: I, II, III, IV, V, VI
System Description: PM CONVENTIONAL
Repair System Description: PM - INNOVATIVE
Maintenance Agreement Required: ☐ Yes ☑ No


☑ House/Mod. Home No. Bedrooms 3
☐ Mobile Home No. Bathrooms 2
☐ Business No. Employees
☐ Other
☐ Slab ☑ Crawl Space ☐ Basement w/plumbing ☐ Basement wo/plumbing

Water Supply: ☑ Individual ☐ Public ☐ Community


Comments:/Conditions: 1-10-01 House plan flipped. Tanks to be located off right side of house.

Comments:/Conditions: Tanks & LINES & PRESSURE Checked 1/11/2001

1"=50' INITIAL SITE SKETCH

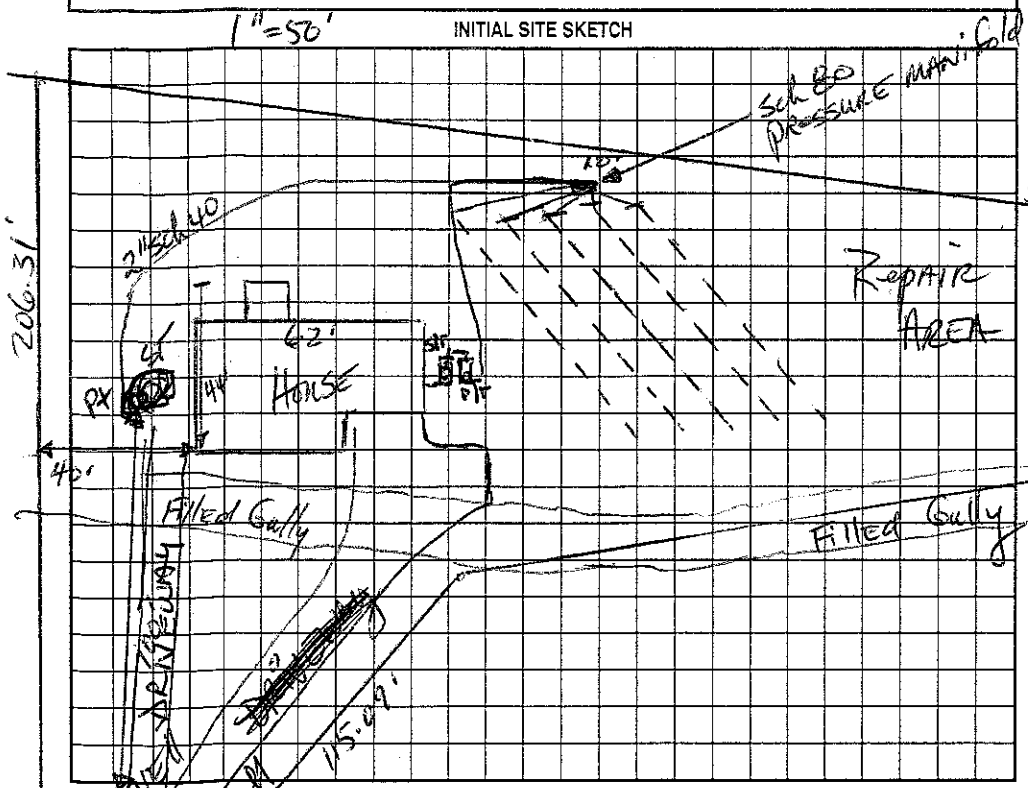

AS BUILT SKETCH

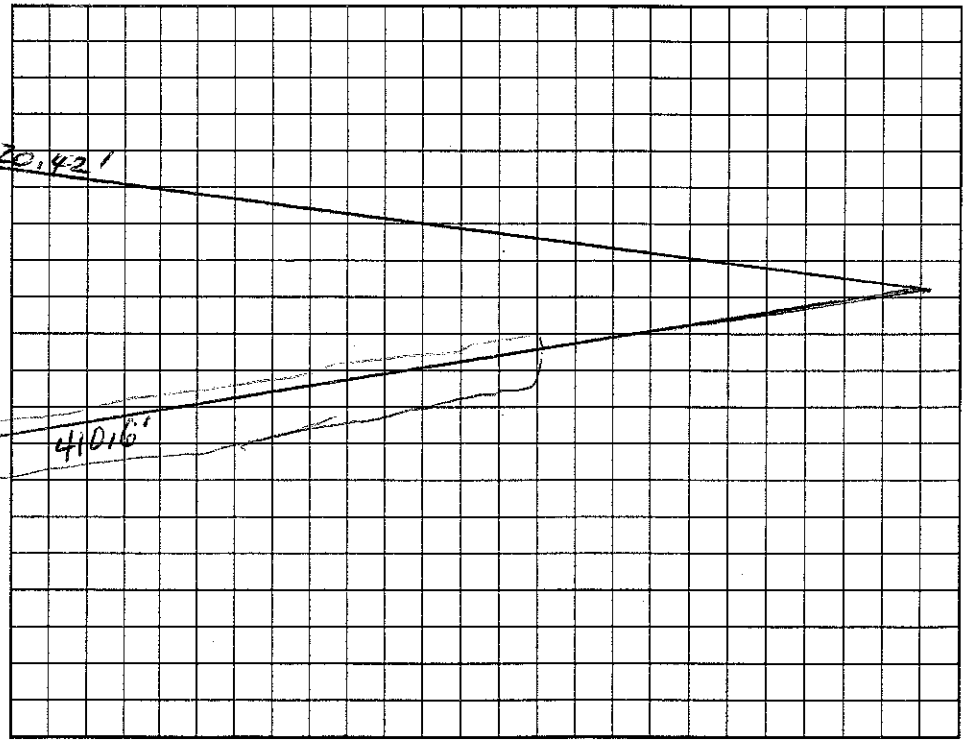

Permit can be suspended or revoked if any false information is supplied toward securing the permit/any unauthorized changes are made to the site/any unauthorized changes are made in the installation of the system. Improvement Permit with plan valid without expiration. Improvement Permit with site plan valid for sixty months. Authorization to Construct is valid for a period equal to that of Improvement Permit – not to exceed sixty months.

R/W

Signed: date 10.24.00 Installed by: Tommy Frye

Improvement Permit by: DR Thomas RS date 10-23-00 Operation Permit by: Wesley Hardin RS date 3/22/01

Authorization to Construct by: DR Thomas RS date 10-23-00 Existing System Inspection by: date

HEALTH DEPT. COPY: WHITE OWNER COPY (FINAL): YELLOW OWNER COPY (INITIAL): PINK