IREDELL COUNTY HEALTH DEPARTMENT

STATESVILLE 704-878-5305 MOORESVILLE 704-664-5281

IMPROVEMENT PERMIT / AUTHORIZATION TO CONSTRUCT / OPERATION PERMIT / EXISTING SYSTEM INSPECTION

2400

PERMIT# 104607 PIN# 4659-92-5352.91 4669-02-1010 DATE July 19, 02

OWNER OR CONTRACTOR KFS Investments / E.S. JOHNSON BLDRS. PHONE: Business 704-799-2976 Home

ADDRESS 149 Yacht Cove Ln. Mooresville 28117

LOCATION 115-21 N TR Shinnville Rd TL Brookglen Dr. 399 Brookglen cross-creek BEAR Right on Right

SUBDIVISION Brookglen BLOCK / SECTION 2 LOT 91 LOT AREA 1.33 Ac SITE CLASS. PS DESIGN FLOW 360 gpd L.T.A.R. .25

Septic Tank: 1000 Gallons; STB 10/12 Date 12/14/02

Pump Tank: 1000 Gallons; PT 17 Date 5/7/03

Pump Make: Goulds Model WE0511H Serial No. E036571G

Nitrification Field: No Fields 1 Square Feet 1080 Linear Feet 360

No Lines 3 @ 120' Trench Width 36" Trench Bottom Depth 36"

☑ New System ☐ Repair System Type: I, II, III, IV, V, VI

System Description: pm 25% Reduction

Repair System Description: LPPPBPS

Maintenance Agreement Required: ☐ Yes ☑ No initially

Gravel Depth NA ☐ Slab ☑ Crawl Space ☐ Basement w/plumbing ☐ Basement wo/plumbing

☑ House/Mod. Home No. Bedrooms 3

☐ Mobile Home No. Bathrooms 2

☐ Business No. Employees

☐ Other


Water Supply: ☑ Individual ☐ Public ☐ Community

Comments:/Conditions: INSTALL LATERALS AT 36" trench bottom depth. Remove any old burnt terraces in septic system area.

Comments:/Conditions: Tanks checked by GM Lines & pressure checked 6/20/03 mg

1" = 100'

INITIAL SITE SKETCH

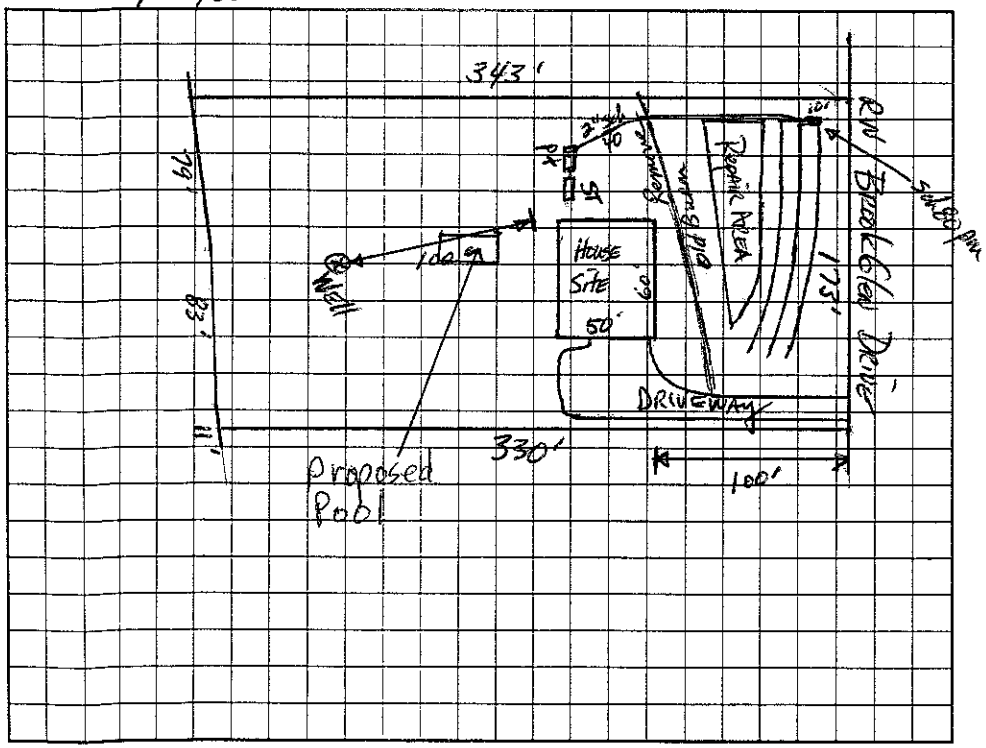

AS BUILT SKETCH

EZ Flow Drainfield Installed

The proposed / existing Pool addition does not appear to impact the existing septic system.

**NOTE: Shall be min. 15' from septic tanks

Andy Melville R.S.

Date: 01-13-12

ICHD-Environmental Health Division

Permit can be suspended or revoked if any false information is supplied toward securing the permit/any unauthorized changes are made to the site/any unauthorized changes are made in the installation of the system. Improvement Permit with plat valid without expiration. Improvement Permit with site plan valid for sixty months. Authorization to Construct is valid for a period equal to that of Improvement Permit – not to exceed sixty months.

Signed: date 8-9-02 Installed by: Tommy Fryer

Improvement Permit by: R.S. date 7-19-02 Operation Permit by: R.S. date 7/22/03

Authorization to Construct by: R.S. date 1/17/03 Existing System Inspection by: date

HEALTH DEPT. COPY: WHITE OWNER COPY (FINAL): YELLOW OWNER COPY (INITIAL): PINK