# IREDELL COUNTY HEALTH DEPARTMENT

STATESVILLE 704-878-5305 MOORESVILLE 704-664-5281

## IMPROVEMENT PERMIT / AUTHORIZATION TO CONSTRUCT / OPERATION PERMIT / EXISTING SYSTEM INSPECTI

PERMIT# 104561 PIN# 4659-92-5352.89 4669-02-1155 DATE July 19, 02

OWNER OR CONTRACTOR KFS Investments, II ES Johnson Bldrs. PHONE: Business Home

ADDRESS 149 Yacht Cove Ln. Mooresville NC 28117

LOCATION 115-21N TR Shannville Rd TL Brookglen Dr. cross creek BEAR Right on Right #391

SUBDIVISION BrookGlen BLOCK / SECTION 2 LOT 89, 89A LOT AREA 1.3Ac +.19Ac SITE CLASS PS*

DESIGN FLOW 360gpd L.T.A.R. .35 on 89A + .1 LPP Repair

Septic Tank: 1000 Gallons; STB 1012 Date 12/14/02

Pump Tank: 1000 Gallons; PT 17 Date 4/23/03

Pump Make Gould's Model WE05H Serial No. E036571

Nitrification Field: No Fields 1 Square Feet 780 Linear Feet 260

No Lines 3 Trench Width 36" Trench Bottom Depth 36" Gravel Depth NA

☑ New System ☐ Repair System Type: I, II, III, IV, V, VI

System Description: PM- 25% Reduction on 89A*

Repair System Description: LPP w/ FR-Drain on Lot 89*

Maintenance Agreement Required: ☐ Yes ☑ No initially

☐ House/Mod. Home No. Bedrooms 3

☐ Mobile Home No. Bathrooms 2

☐ Business No. Employees

☐ Other

☐ Slab ☑ Crawl Space ☐ Basement w/plumbing ☐ Basement wo/plumbing


Water Supply: ☑ Individual ☐ Public ☐ Community

Comments:/Conditions: Install Laterals at 36" trench bottom depth per initial system. Remove any old burns/terraces in septic system area.

Comments:/Conditions: Tanks checked by GM Lines & pressure checked by MD 6/20/03

1"=100'

INITIAL SITE SKETCH

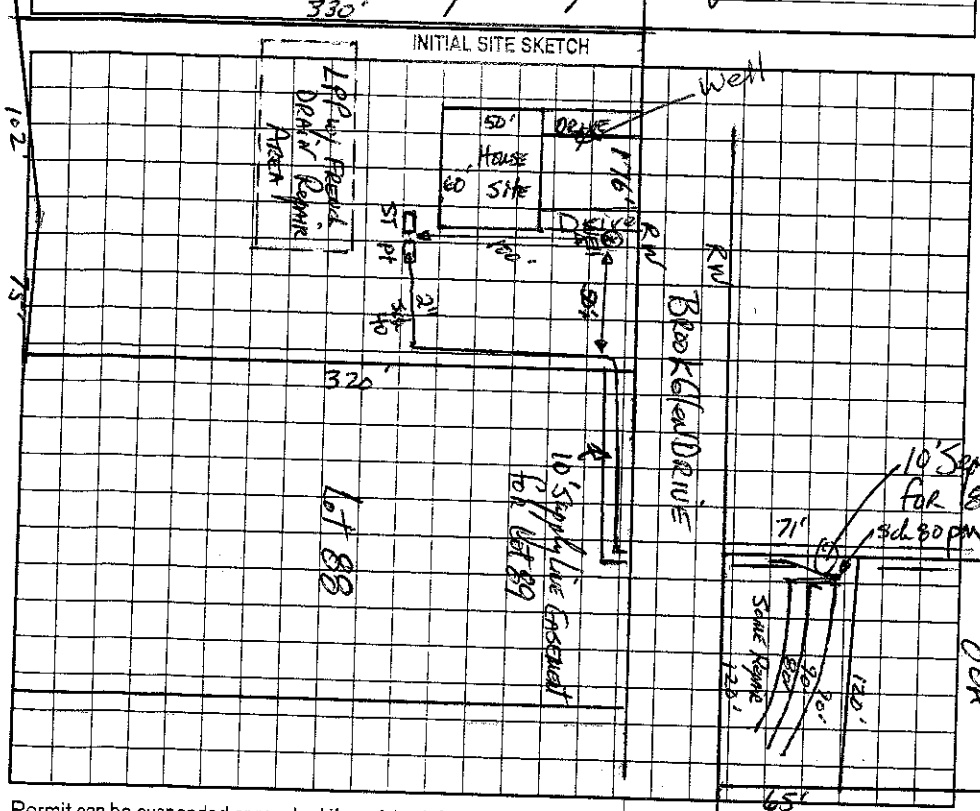


AS BUILT SKETCH

Installed EZ Flow Drainfield Installed as Drawn

Permit can be suspended or revoked if any false information is supplied toward securing the permit/any unauthorized changes are made to the site/any unauthorized changes are made in the installation of the system. Improvement Permit with plat valid without expiration. Improvement Permit with site plan valid for sixty months. Authorization to Construct is valid for a period equal to that of Improvement Permit – not to exceed sixty months.

Signed:

Improvement Permit by: date 8-9-02

Authorization to Construct by: date 7-9-02

Installed by: Tommy Faye RS

Operation Permit by: date 8/12/03

Existing System Inspection by: date

HEALTH DEPT. COPY: WHITE OWNER COPY (FINAL): YELLOW OWNER COPY (INITIAL): PINK