IREDELL COUNTY HEALTH DEPARTMENT

STATESVILLE 704-878-5305 MOORESVILLE 704-664-5281

IMPROVEMENT PERMIT / AUTHORIZATION TO CONSTRUCT / OPERATION PERMIT / EXISTING SYSTEM INSPECTION

PERMIT# 104560 PIN# 4659-92-5352, 88 4669-02-1393 DATE July 19, 02

OWNER OR CONTRACTOR KFS Investments // ES Johnson Builders PHONE: Business Home

ADDRESS 149 Yacht Cove Ln. Mooresville 28117 353 Brookglen

LOCATION 115-21 N. TR Shinnsville Rd. TL Brookglen Dr. cross Oak Bear Right on Right

SUBDIVISION Brookglen BLOCK / SECTION 2 LOT 88, 88A LOT AREA 1.31Ac +, 43Ac SITE CLASS PS SFE DESIGN FLOW 360gpd L.T.A.R. .03 on 88A system area

Septic Tank: 1000 Gallons; STB 1012 Date 12/14/02

Pump Tank: 1000 Gallons; PT 17 Date 4/27/03

Pump Make: Goulds Model WE0712H Serial No. E03627488

Nitrification Field: No Fields 1 Square Feet 900 Linear Feet 300

No Lines 5@60' Trench Width 36" Trench Bottom Depth 36" Gravel Depth NA

☑ New System ☐ Repair System Type: I, II, III, IV, V, VI

System Description: PM 25% Reduction on SFE 88A

Repair System Description: SAME ON 88A

Maintenance Agreement Required: ☐ Yes ☑ No

☑ House/Mod. Home No. Bedrooms 3

☐ Mobile Home No. Bathrooms 2

☐ Business No. Employees

☐ Other

☐ Slab ☑ Crawl Space ☐ Basement w/plumbing ☐ Basement wo/plumbing


Water Supply: ☑ Individual ☐ Public ☐ Community

Comments:/Conditions: Install laterals at 36" trench bottom depth. Remove any old burns / furnaces in septic system area.


Comments:/Conditions: Tanks checked by GM Drainfield laterals exactly 10' off RL Supply line ~ 5' off RL Pressure & lines checked 6/20/03 MD

1"=100'

INITIAL SITE SKETCH

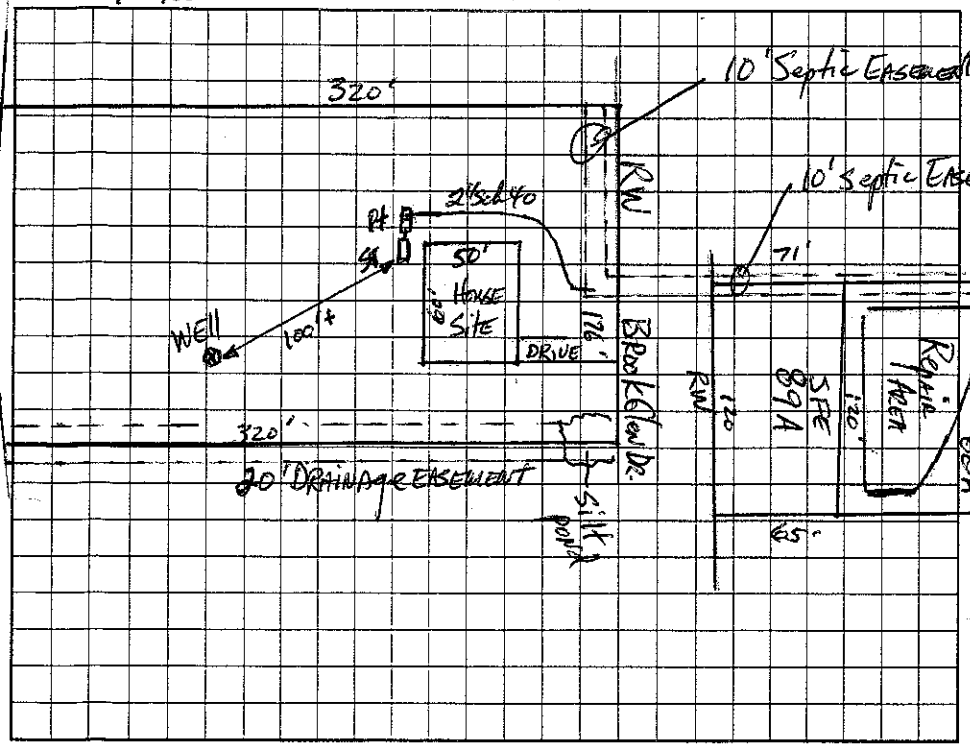

AS BUILT SKETCH

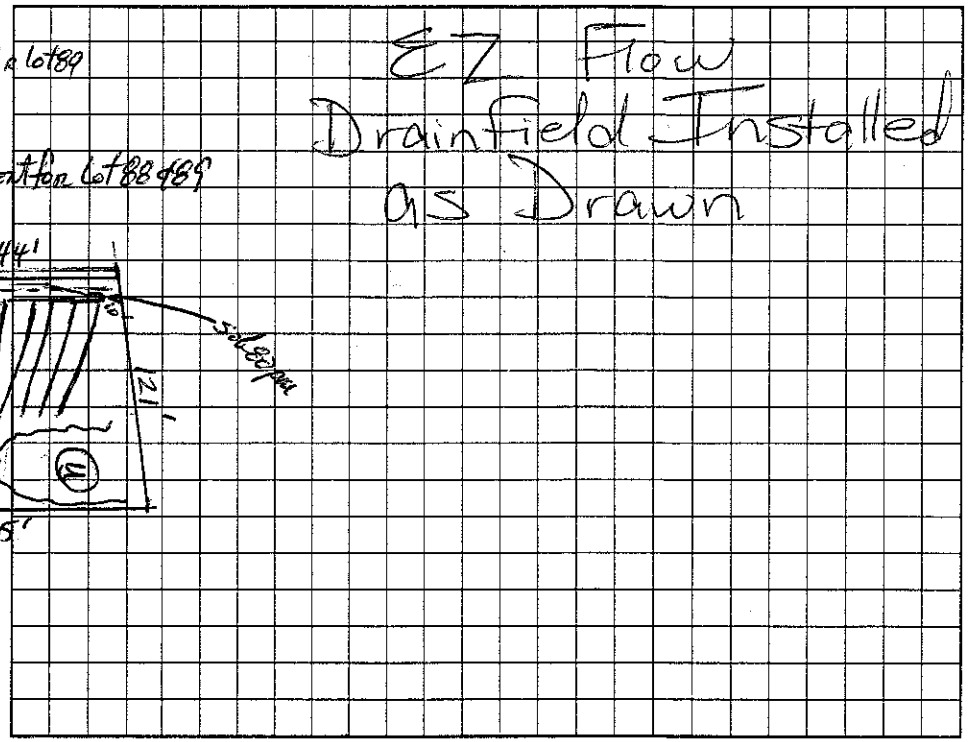

Permit can be suspended or revoked if any false information is supplied toward securing the permit/any unauthorized changes are made to the site/any unauthorized changes are made in the installation of the system. Improvement Permit with plat valid without expiration. Improvement Permit with site plan valid for sixty months. Authorization to Construct is valid for a period equal to that of Improvement Permit – not to exceed sixty months.

Signed: date 8-9-02

Improvement Permit by: date 7-19-02

Authorization to Construct by: date 2-28-03

Installed by: Tommy Frye

Operation Permit by: RS date 7/22/03

Existing System Inspection by: date

HEALTH DEPT. COPY: WHITE OWNER COPY (FINAL): YELLOW OWNER COPY (INITIAL): PINK