IREDELL COUNTY HEALTH DEPARTMENT

STATESVILLE 704-878-5305 MOORESVILLE 704-664-5281

IMPROVEMENT PERMIT / AUTHORIZATION TO CONSTRUCT / OPERATION PERMIT / EXISTING SYSTEM INSPECTIO.

PERMIT# 104500 PIN# ~~4659-92-5352.85~~ 4669-02-2777 DATE July 18, 02

OWNER OR CONTRACTOR KFS Investments PHONE: Business _____ Home _____

ADDRESS 149 Yacht Cove Ln. Mooresville 28117

LOCATION 115-21N TR Shinnville Rd. TL Brookglen DR. cross creek Bear Right on Right

SUBDIVISION Brookglen BLOCK / SECTION 2 LOT 85 LOT AREA 1.2Ac SITE CLASS. PS DESIGN FLOW 360gpd L.T.A.R. ~.25

Septic Tank: 1000 Gallons; STB 794 Date 9/22/03

Pump Tank: _____ Gallons; PT _____ Date _____

Pump Make: _____ Model _____ Serial No. _____

Nitrification Field: No Fields ____ Square Feet 500/750 Linear Feet 250

No Lines 5@50' Trench Width 24" min 86c Max Trench Bottom Depth 36" Gravel Depth NA

☑ New System ☐ Repair System Type: I II III IV V VI

System Description: Gravity 50% Reduction (PPBPS)

Repair System Description: LP PPBPS

Maintenance Agreement Required: ☐ Yes ☑ No ~~Initially~~

☑ House/Mod. Home No. Bedrooms 3

☐ Mobile Home No. Bathrooms 2

☐ Business No. Employees ____

☐ Other _____

☐ Slab ☑ Crawl Space ☐ Basement w/plumbing ☐ Basement wo/plumbing

Water Supply: ☑ Individual ☐ Public ☐ Community

Comments:/Conditions: OR 36" MIN 9'oc


Remove any old burns / terraces in septic system area.

Comments:/Conditions: Reviewed site & building plans 8/11/03, essentially in compliance with original permit.


Checked tanks 10/31/03

1" = 100'

INITIAL SITE SKETCH

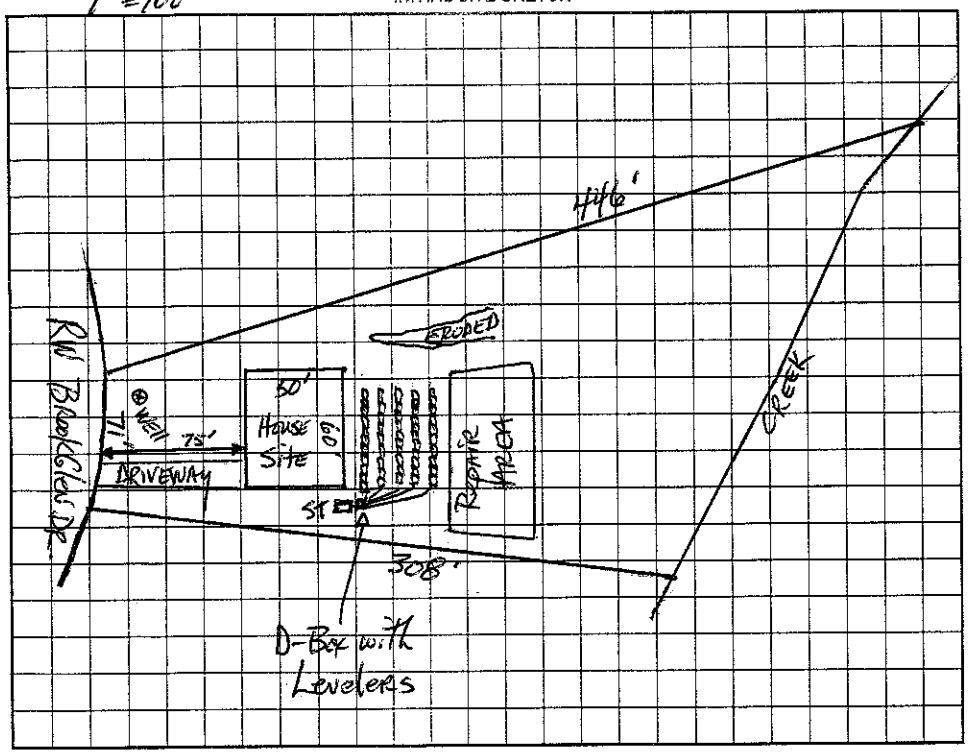

AS BUILT SKETCH

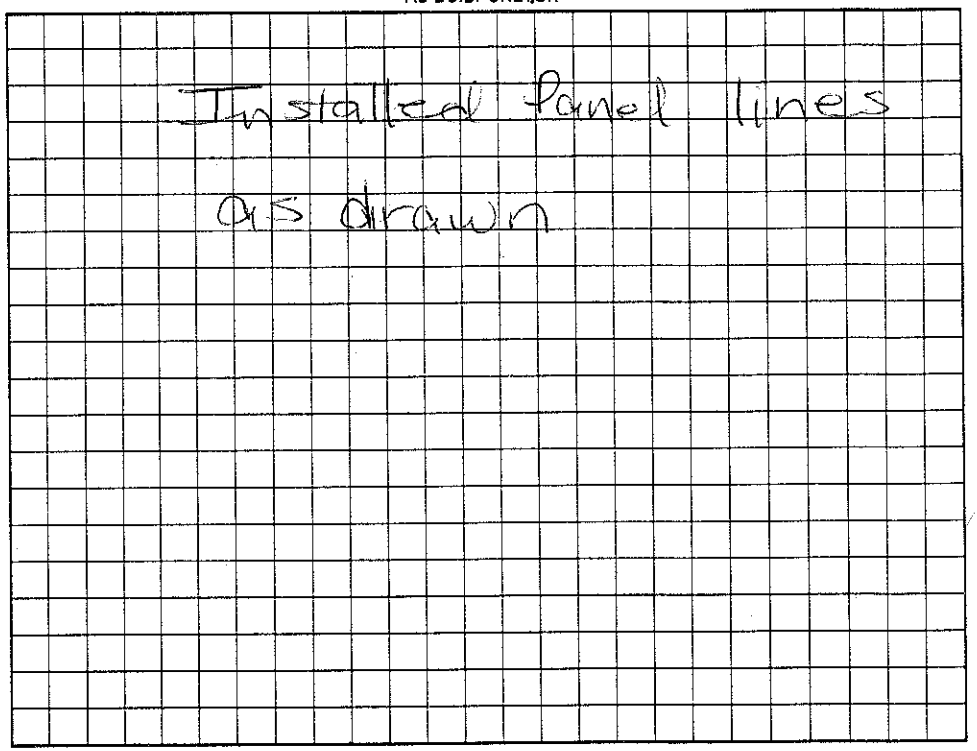

Permit can be suspended or revoked if any false information is supplied toward securing the permit/any unauthorized changes are made to the site/any unauthorized changes are made in the installation of the system. Improvement Permit with plat valid without expiration. Improvement Permit with site plan valid for sixty months. Authorization to Construct is valid for a period equal to that of Improvement Permit – not to exceed sixty months.

Signed: _____ date 8-9-02 Installed by: Willie Christenbury RS

Improvement Permit by: _____ RS date 7-18-02 Operation Permit by: _____ date 11/13/03

Authorization to Construct by: _____ RS date 8/11/03 Existing System Inspection by: _____ date _____

HEALTH DEPT. COPY: WHITE OWNER COPY (FINAL): YELLOW OWNER COPY (INITIAL): PINK