2130

IREDELL COUNTY HEALTH DEPARTMENT

STATESVILLE 704-878-5305 MOORESVILLE 704-664-5281

IMPROVEMENT PERMIT / AUTHORIZATION TO CONSTRUCT / OPERATION PERMIT / EXISTING SYSTEM INSPECTION

PERMIT# 104498 PIN# ~~4659-92-5352.83~~ ~~4659~~ 4669-03-3469 DATE July 18, 02

OWNER OR CONTRACTOR KFS Investments / Calkins Const. PHONE Business Home

ADDRESS 149 Gulet Cove Ln. Mooresville 28117

LOCATION 115-21N TR Shinnville Rd. TL Brookglen Dr. on left

SUBDIVISION Brookglen BLOCK / SECTION 2 LOT 83 LOT AREA 5.65Ac SITE CLASS. P5 DESIGN FLOW 360 gpd L.T.A.R. 0.25

Septic Tank: 1000 Gallons; STB 312 Date 5-15-05
Pump Tank: Gallons; PT Date
Pump Make: Model Serial No.
Nitrification Field: No Fields 1 Square Feet 1440 Linear Feet 480
No Lines 4@120' Trench Width 36" Max Trench Bottom Depth 36" Gravel Depth 12"


☑ New System ☐ Repair System Type: I, II, III, IV, V 25%
System Description: Gravity Conventional / Reduction Accepted
Repair System Description: Gravity 25% Reduction
Maintenance Agreement Required: ☐ Yes ☑ No

☐ House/Mod. Home No. Bedrooms 3
☐ Mobile Home No. Bathrooms 2
☐ Business No. Employees
☐ Other
☐ Slab ☑ Crawl Space ☐ Basement w/plumbing ☐ Basement wo/plumbing

Water Supply: ☑ Individual ☐ Public ☐ Community


Comments:/Conditions:
Remove any old burns / terraces in septic system area
Reviewed Building plans 1/3/05. mjs

1"=100' INITIAL SITE SKETCH

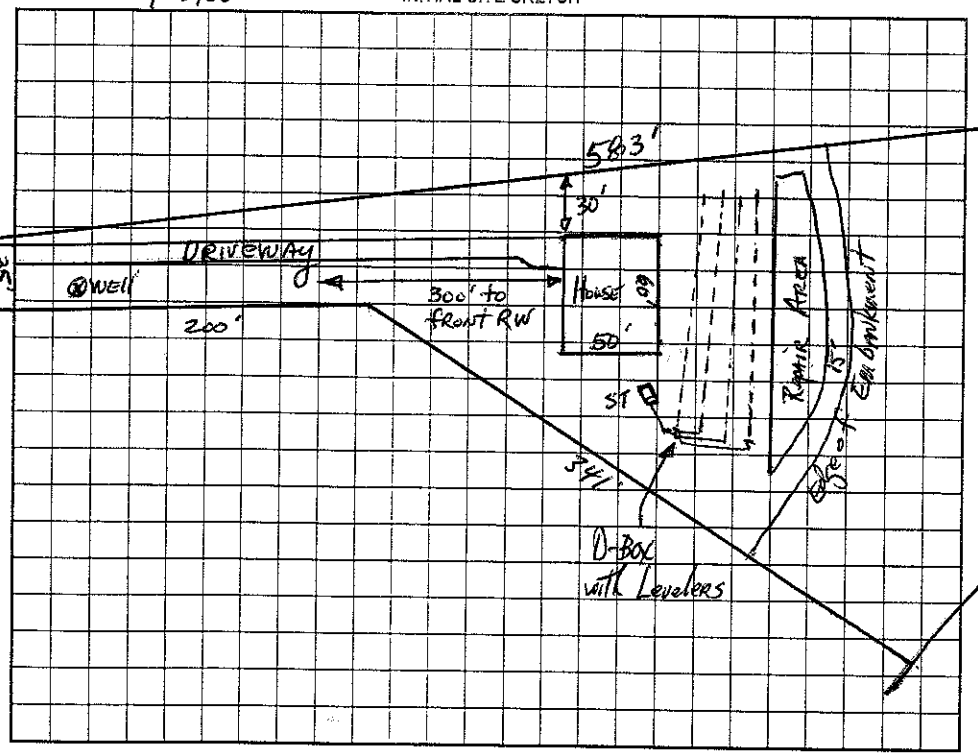

Comments:/Conditions:
Note: House is being moved Closer to road. 263' instead of 300'
Okay to put detached garage on side of house.

AS BUILT SKETCH

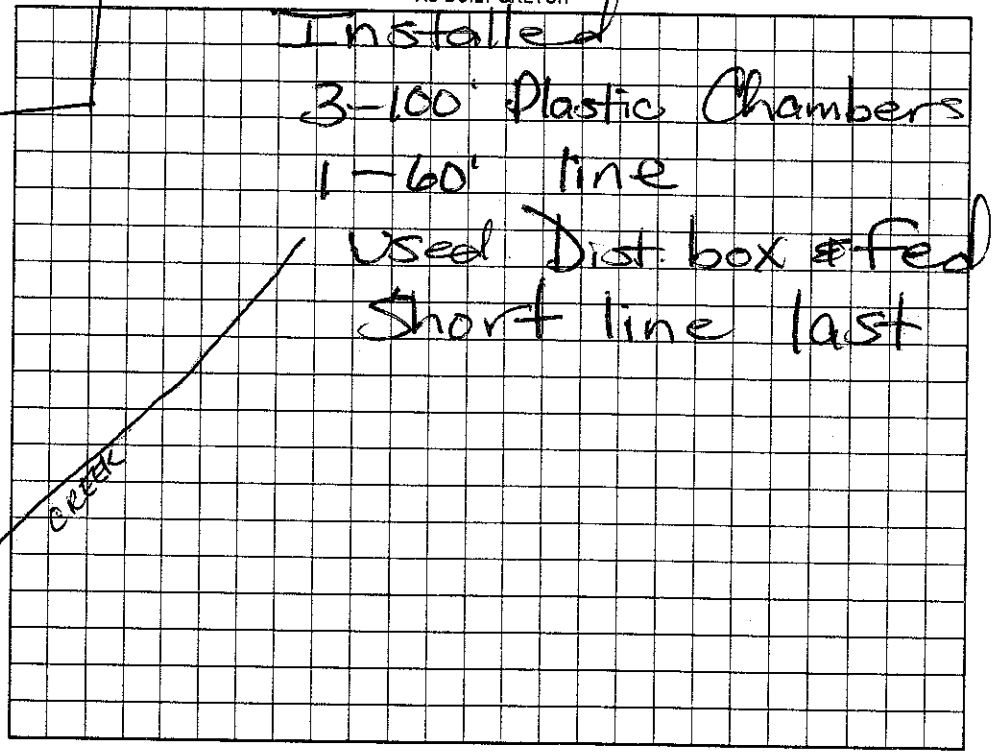

Permit can be suspended or revoked if any false information is supplied toward securing the permit/any unauthorized changes are made to the site/any unauthorized changes are made in the installation of the system. Improvement Permit with plat valid without expiration. Improvement Permit with site plan valid for sixty months. Authorization to Construct is valid for a period equal to that of Improvement Permit - not to exceed sixty months.

Signed:

Improvement Permit by: date 8-9-02

Authorization to Construct by: date 7-18-02 date 1/3/05

Installed by: Willie Christenbury RS

Operation Permit by: date 7/6/05

Existing System Inspection by: date

HEALTH DEPT. COPY: WHITE OWNER COPY (FINAL): YELLOW OWNER COPY (INITIAL): PINK