IREDELL COUNTY HEALTH DEPARTMENT

STATESVILLE 704-878-5305 MOORESVILLE 704-664-5281

IMPROVEMENT PERMIT / CERTIFICATE OF COMPLETION / OPERATION PERMIT / EXISTING SYSTEM INSPECTION

PROPERTY DESCRIPTION NO. 21245 DATE 6/14/95 TAX MAP NO. ~~4665-2-14-10~~ 4665 04 7680 Watershed: ☐ Yes ☒ No

OWNER OR CONTRACTOR Roger R Smith PHONE: Business _____ Home 663-6732

ADDRESS 704 E Shadell Cir. Mooresville, NC. 28115

LOCATION Shinnicks Rd. TL on Springdale Dr. mans end on (R) 3rd lot Landscaped large

SUBDIVISION Springdale BLOCK / SECTION _____ LOT 10 LOT AREA 26,000 FT² SITE CLASS. PS DESIGN FLOW 360 L.T.A.R. .3

Septic Tank: 1000 Gallons; STB 825 Date 7/7/96

Pump Tank: 1000 Gallons; PT 40 Date 5/5/96

Pump Make: _____ Model _____ Serial No. _____

Nitrification Field: No Fields 1 Square Feet 1200 Linear Feet (200) 400

No Lines 4 Trench Width 24" Max Trench Bottom Depth 32" Gravel Depth 6" SAND

☒ New System ☐ Repair System Type: I, II, (III) IV, V, VI

System Description: Pressman - Panel 16

Repair System Description: Same

Maintenance Agreement Required: ☐ Yes ☒ No

☒ House/Mod. Home No. Bedrooms 3

☒ Mobile Home No. Bathrooms 2

☐ Business No. Employees _____

☐ Other D/W


☐ Slab ☒ Crawl Space ☐ Basement w/plumbing ☐ Basement wo/plumbing

Water Supply: ☒ Individual ☐ Community ☐ Public

Comments: * 50% reduction for Prefab Panel use

Comments: Lines, Tanks, Pressure checked 8/9/96

INITIAL SITE SKETCH

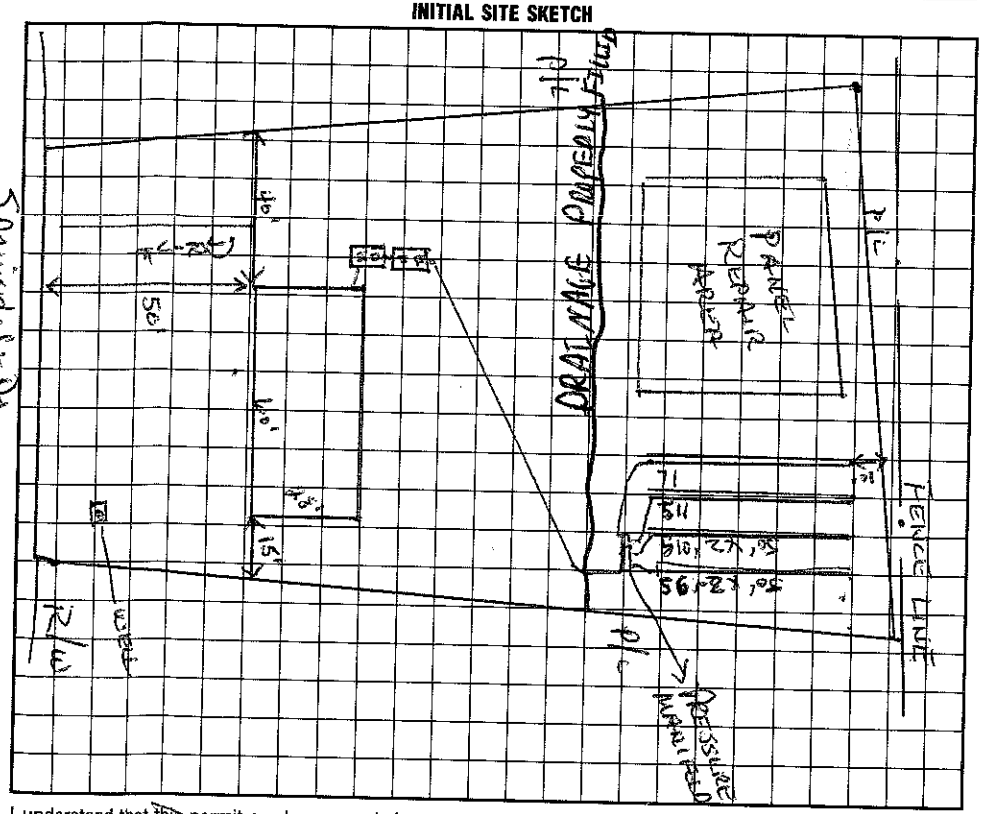

AS BUILT SKETCH

I understand that this permit can be suspended or revoked if any false information is supplied toward securing the permit/any unauthorized changes are made to the site/any unauthorized changes are made in the installation of the system. Improvement Permit is valid for 60 months from date of issuance.

Signed: _____ Agent

Improvement Permit by: Wesley Sparks RS. date 6/14/95

Existing System Inspection by: _____ date _____

Installed by: G & M Enterprises

Certificate of Completion by: _____ date _____

Operation Permit by: ICHD STAFF date 7/2012

HEALTH DEPT. COPY: WHITE INSPECTION COPY (FINAL): GREEN OWNER COPY (FINAL): YELLOW INSPECTION COPY (INITIAL): PINK OWNER COPY (INITIAL): GOLD