IREDELL COUNTY HEALTH DEPARTMENT

STATESVILLE 704-878-5305 155.00 Paid MOORESVILLE 704-664-5281

IMPROVEMENT PERMIT / AUTHORIZATION TO CONSTRUCT / OPERATION PERMIT / EXISTING SYSTEM INSPECTION

PERMIT# 94272 PIN# 4669-05-0834 4669050699 DATE 3/20/02

OWNER OR CONTRACTOR Wayne & Vicky Stowe PHONE: Business _____ Home 664-2486

ADDRESS 112 Market Rd. Mooresville NC 28115

LOCATION 115 N, R Shepards, R Stow away Near End on Rt

SUBDIVISION _____ BLOCK / SECTION _____ LOT _____ LOT AREA 9.034Ac. SITE CLASS. PS DESIGN FLOW 240 L.T.A.R. 0.3

Septic Tank: 1000 Gallons; STB 1007 Date 2/6/02
Pump Tank: _____ Gallons; PT _____ Date _____
Pump Make: _____ Model _____ Serial No. _____
Nitrification Field: No Fields 1 Square Feet 600 Linear Feet 200
No Lines 2* or 3* Trench Width 36" Max Trench Bottom Depth 36" Gravel Depth —

☒ New System ☐ Repair System Type: I, II, III, IV, V, VI
System Description: Gravity 25% Reduc.
Repair System Description: Same
Maintenance Agreement Required: ☐ Yes ☒ No

☒ House/Mod. Home ☐ Mobile Home ☐ Business ☐ Other
No. Bedrooms 2 No. Bathrooms 2.5 No. Employees ____


☐ Slab ☐ Crawl Space ☒ Basement w/plumbing ☐ Basement wo/plumbing

Water Supply: ☒ Individual ☐ Public ☐ Community

Comments:/Conditions:

Comments:/Conditions:

INITIAL SITE SKETCH

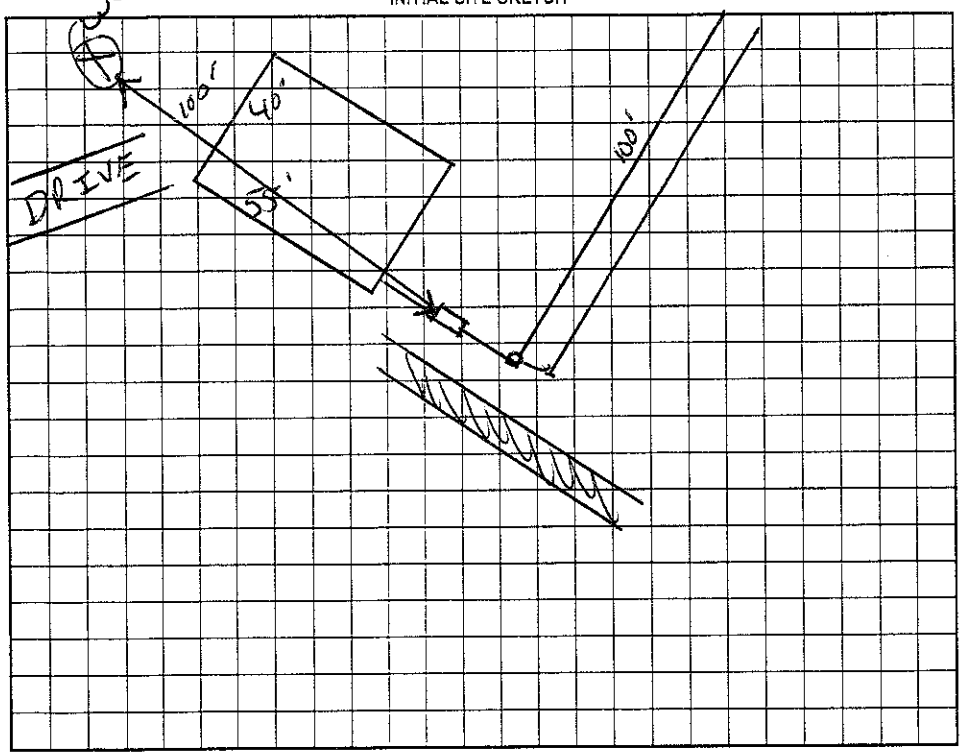

AS BUILT SKETCH

Permit can be suspended or revoked if any false information is supplied toward securing the permit/any unauthorized changes are made to the site/any unauthorized changes are made in the installation of the system. Improvement Permit with plat valid without expiration. Improvement Permit with site plan valid for sixty months. Authorization to Construct is valid for a period equal to that of Improvement Permit – not to exceed sixty months.

Signed: Michael Shane Hill date 3-20-02 Installed by: A & S Grading

Improvement Permit by: RS date 3/20/02 Operation Permit by: RS date 3/25/02

Authorization to Construct by: RS date 3/20/02 Existing System Inspection by: _____ date _____

HEALTH DEPT. COPY: WHITE OWNER COPY (FINAL): YELLOW OWNER COPY (INITIAL): PINK