# IREDELL COUNTY HEALTH DEPARTMENT

Redraw Cues & corrected Plat

STATESVILLE 704-878-5305 — ESVILLE 704-664-5281

## IMPROVEMENT PERMIT / AUTHORIZATION TO CONSTRUCT / OPERATION PERMIT / L... ING SYSTEM INSPECTION

PERMIT# 141992 PIN# 4669111776.009 4669-11-1653 DATE 12/11/07

OWNER OR APPLICANT Emil Bec PHONE: Business 704 526-7115 Home

ADDRESS 225 Mott Rd.

LOCATION Hwy 115 N - RT Statesville Rd TL Albany Rd - 4th Lot on Left

SUBDIVISION Bethany Place BLOCK / SECTION LOT 4 LOT AREA .7 SITE CLASS PS DESIGN FLOW 360 L.T.A.R. .3

Septic Tank: 1000 Gallons; STB 825 Date 6/02/08

Pump Tank: Gallons; PT Date

Pump Make: Model Serial No.

Nitrification Field: No Fields 1 Square Feet 600 Linear Feet 200'

No Lines 4@50' Trench Width 24" 8'05 Max Trench Bottom Depth 36"

☑ New System ☐ Repair ☐ Expansion System Type: I II III IV V VI

System Description: Gravity → PPBPS

Repair System Description: LCP PPBPS

Maintenance Agreement Required: ☐ Yes ☑ No Initial

Gravel Depth N/A ☑ Gravity ☐ Pressure

☑ House/Mod. Home ☐ Mobile Home ☐ Business ☐ Other

No. Bedrooms 3 No. Persons No. Employees

Water Supply: ☑ Individual ☐ Public ☐ Community

☐ Slab ☑ Crawl Space ☐ Basement w/plumbing ☐ Basement wo/plumbing

Comments:/Conditions: 4 lines of Panel 50' each, drainlines cannot go into powerline right of way


Lines may go into hill 3-4"

Start lines at 32" deep

Do not exceed max depth.

Comments:/Conditions: * Before OP can be issued doorway to 2nd floor bonus room must be arched or cased Emil Bec signed House plans 12/10/07

INITIAL SITE SKETCH

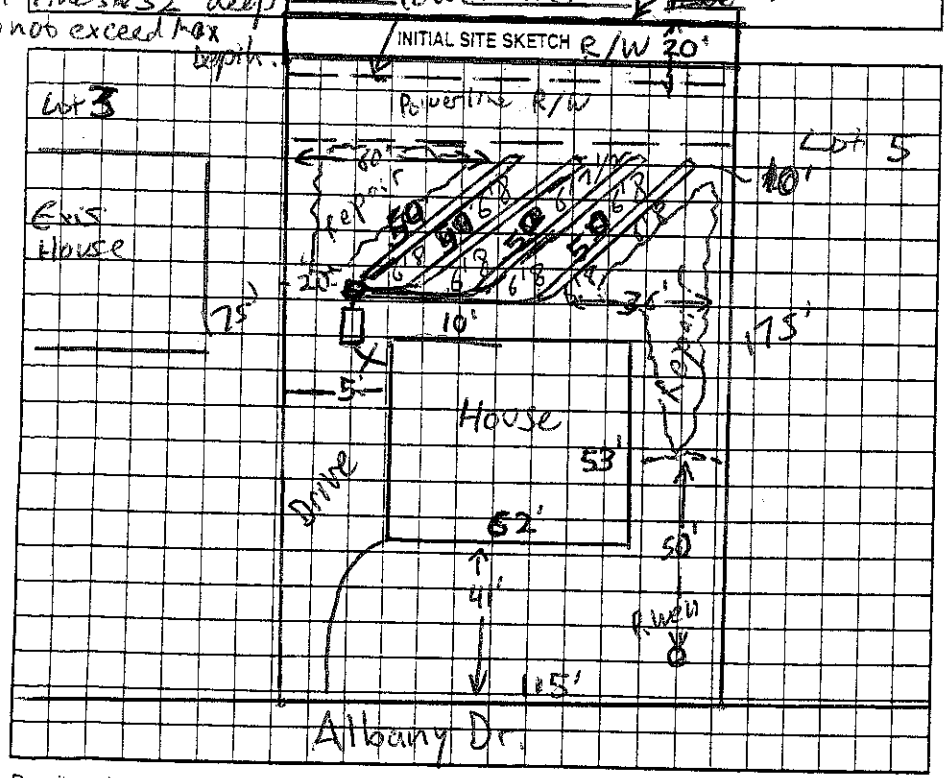


AS BUILT SKETCH

System installed as designed

DBox w/ Flowleveler installed

Permit can be suspended or revoked if any false information is supplied toward securing the permit/any unauthorized changes are made to the site/any unauthorized changes are made in the installation of the system. Improvement Permit with plat valid without expiration ☐ Improvement Permit with site plan valid for sixty months ☑ Authorization to Construct is valid for a period equal to that of Improvement Permit – not to exceed sixty months.

Signed: date 12/12/07 Installed by: Rowan Septic

Improvement Permit by: Anthony Cole Jr date 12/11/07 Operation Permit by: Anthony Cole Jr date 7/16/08

Authorization to Construct by: Anthony Cole Jr date 12/11/07 Existing System Inspection by: V date

HEALTH DEPT. COPY: WHITE OWNER COPY (FINAL): YELLOW OWNER COPY (INITIAL): PINK