IREDELL COUNTY HEALTH DEPARTMENT

Statesville Office (704) 878-5305 | Mooresville Office (704) 660-3625 | PERMIT # 213198

IMPROVEMENT PERMIT / AUTHORIZATION TO CONSTRUCT / OPERATION PERMIT / EXISTING SYSTEM

PIN # 4669-11-3895

APPLICANT: Danny Martinescu | APPLICANT ADDRESS: 1607 High Ridge Drive

SITE ADDRESS: 150 Albany Drive Mooresville, NC | PHONE: 704-361-1090 | ALT. PHONE:

SITE DIRECTIONS: Shinnville Rd → Left on Albany Drive → House on Right

SUBDIVISION: Bethany Place | SECTION: | LOT # 17 | LOT AREA: 0.57 acres | DESIGN FLOW: 480 gal/day | L.T.A.R.: 0.35


Septic Tank	1000 (gal)	STB	794	Date	12-28-15	☒ New System ☐ Repair ☐ Expansion	System Type: I II (III) IV V VI
Pump Tank	— (gal)	PT	—	Date	—	System Description:	25% Reduction
Pump Make	—	Model	—	Serial #	—	Repair System Description:	LP-PPBPS (50% Reduction)
# Nitrification Fields	1	# Lines	4	Linear Ft:	343	Maintenance Agreement Required:	☐ YES ☒ NO
Trench Width	3	Max. Trench Bottom Depth	31"	Gravel Depth	—	☒ GRAVITY	☐ PRESSURE

☒ Residence ☐ Business ☐ Other ☐ Slab ☐ Basement w/plumbing — No. Bedrooms 4 — No. Persons 8 — No. Employees — ☒ Crawl Space — ☐ Basement w/o plumbing


Water Supply: ☒ Private ☐ Public ☐ Community

Comments / Conditions: Follow all N.C. septic rules. Recommend pumping septic tank every 3-5 years.

INITIAL SITE SKETCH

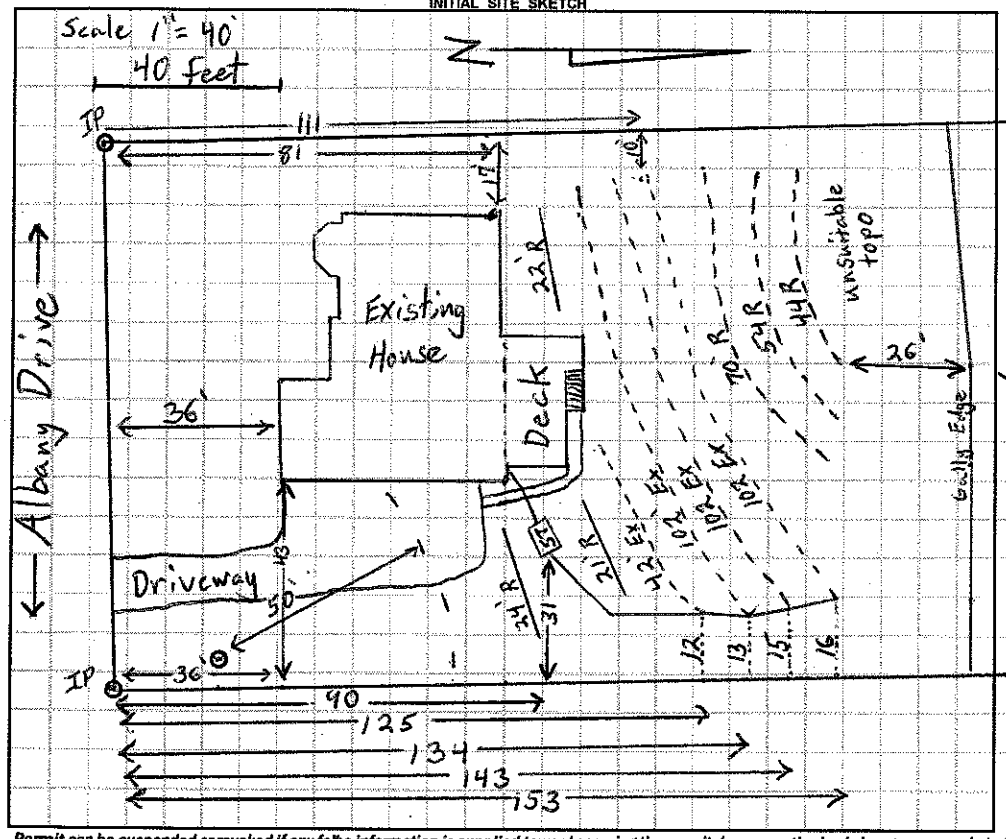

AS BUILT SKETCH

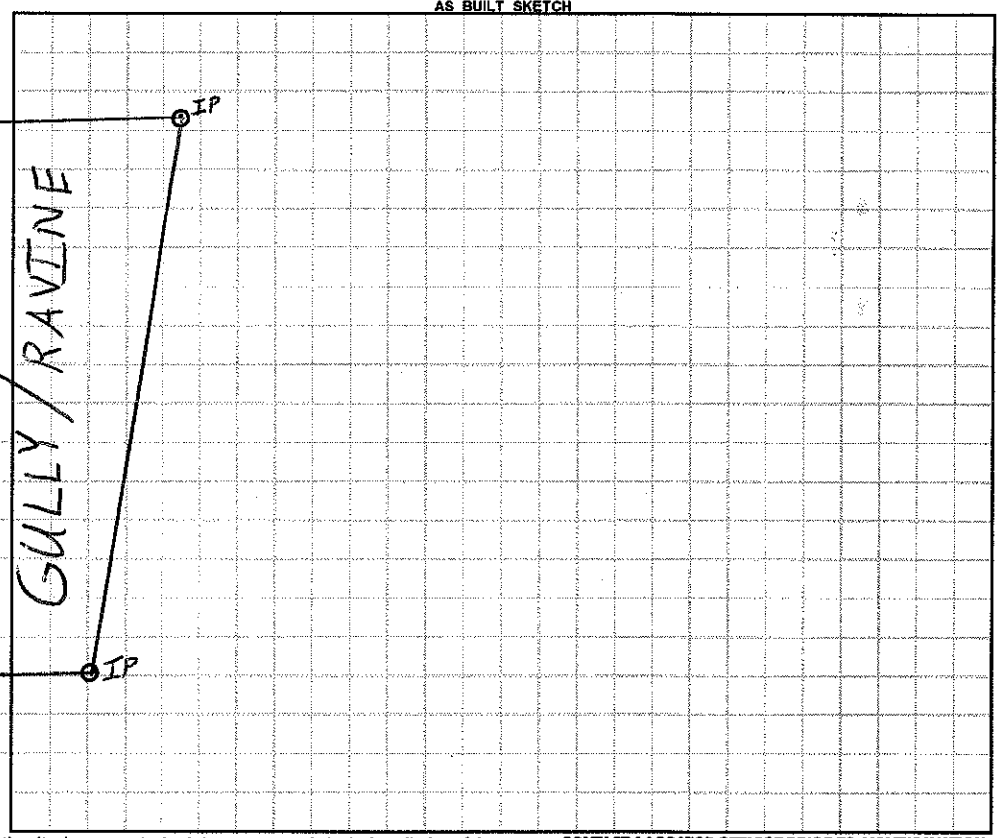

Permit can be suspended or revoked if any false information is supplied toward securing the permit / any unauthorized changes are made to the site / any unauthorized changes are made in the installation of the system. **CONTACT A LOCATOR SERVICE PRIOR TO ANY EXCAVATION**

☐ **IMPROVEMENT PERMIT** *with plat valid without expiration.* ☒ **IMPROVEMENT PERMIT** *with site plan valid for 60 mos.* ☒ **AUTHORIZATION TO CONSTRUCT** *valid for period equal to IMPROVEMENT PERMIT--not to exceed 60 mo.*

Owner / Applicant Signature: [signature] Date: 6-17-16 Installed by: Ken Dillinger

IMPROVEMENT PERMIT by: Tom Shuck Date: 4-29-16 OPERATION PERMIT by: Tom Shuck Date: 4-29-16

AUTHORIZATION TO CONSTRUCT by: Tom Shuck Date: 4-29-16 Existing System Inspected by: Date:

Health Dept. Copy - WHITE Applicant (Final Approval) - YELLOW Applicant (Conditional Approval) - PINK