IREDELL COUNTY HEALTH DEPARTMENT

STATESVILLE 704-878-5305 MOORESVILLE 704-664-5281

IMPROVEMENT PERMIT / AUTHORIZATION TO CONSTRUCT / OPERATION PERMIT / EXISTING SYSTEM INSPECTION

PERMIT# 14185 ZO PIN# ~~4669111776.001~~ 4669-11-5610 DATE 4-30-07

OWNER OR APPLICANT Vasile Lazar PHONE: Business _____ Home _____

ADDRESS 275 Whippoorwill Rd Mooresville 28115

LOCATION 115 N @ Statesville, ~1 Mile ~~to~~ Dept on Albany, 1st lot on Left

SUBDIVISION Bethany Place BLOCK / SECTION _____ LOT 1 LOT AREA _____ SITE CLASS. P.S. DESIGN FLOW 480 L.T.A.R. .30

Septic Tank: 1000 Gallons; STB 583 Date _____

Pump Tank: _____ Gallons; PT _____ Date _____

Pump Make: _____ Model _____ Serial No. _____

Nitrification Field: No Fields 1 Square Feet 1200 Linear Feet 400

No Lines 4 Trench Width 36" Max Trench Bottom Depth 36"

☒ New System ☐ Repair ☐ Expansion System Type: I (II) III IV V VI

System Description: 25% Reduction

Repair System Description: LP Pine

Maintenance Agreement Required: ☐ Yes ☒ No

☒ House/Mod. Home No. Bedrooms 4

☐ Mobile Home No. Persons _____

☐ Business No. Employees _____

☐ Other _____

Water Supply: ☒ Individual ☐ Public ☐ Community

Gravel Depth NA ☒ Gravity ☐ Pressure ☐ Slab ☒ Crawl Space ☐ Basement w/plumbing ☐ Basement wo/plumbing

Comments:/Conditions:


Tank and lines must be at least 5 ft from house, decks, etc + 10' from property lines

Comments:/Conditions:


Well

Albany Rd.

INITIAL SITE SKETCH

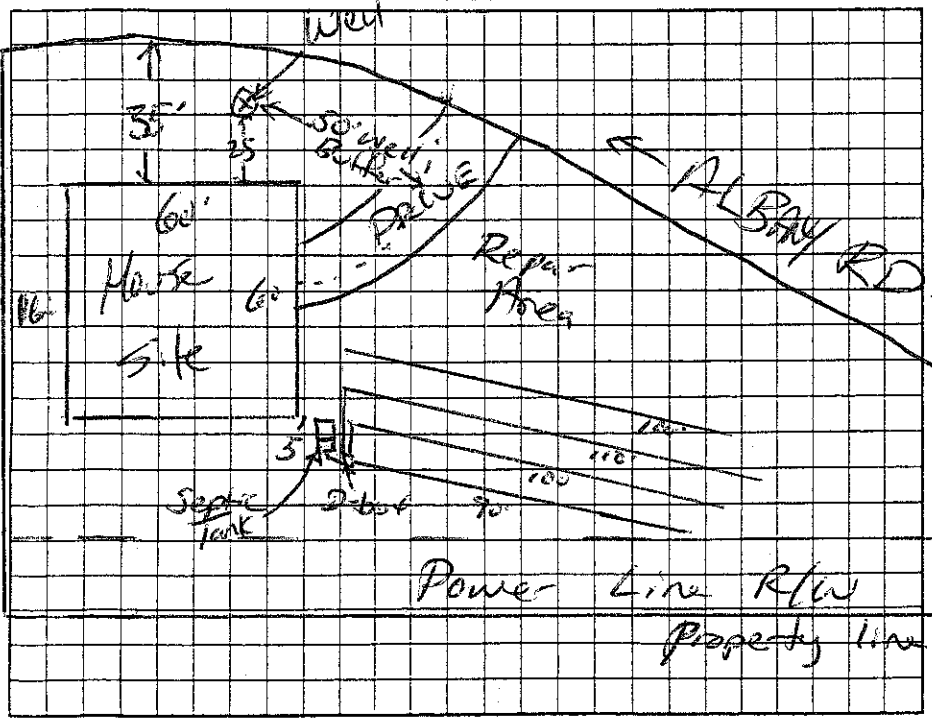

AS BUILT SKETCH

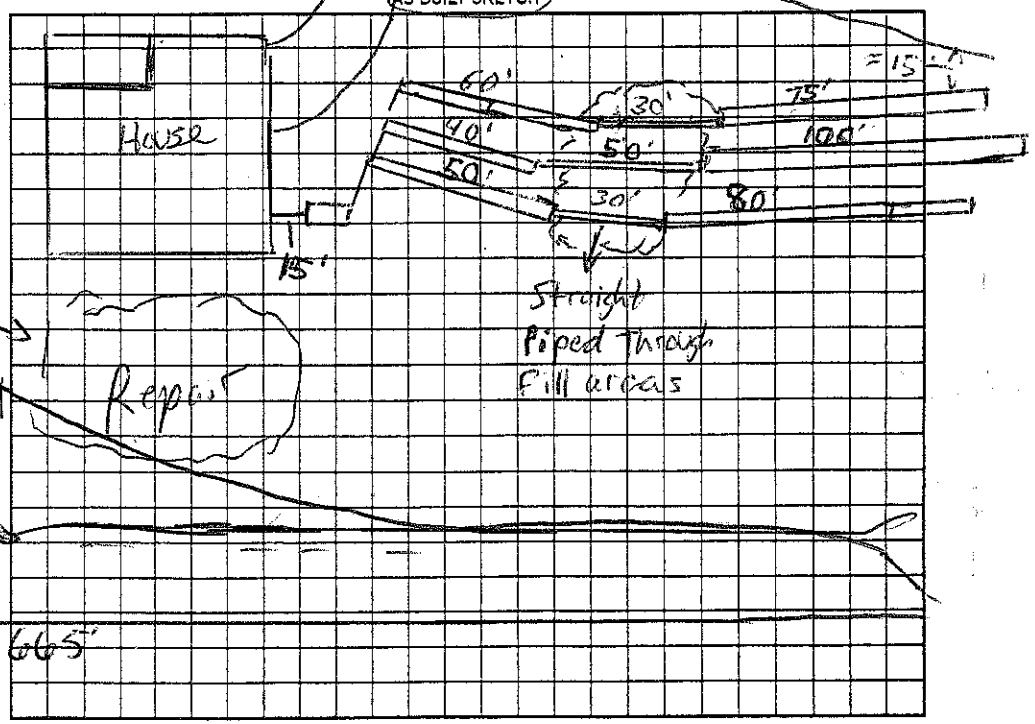

Permit can be suspended or revoked if any false information is supplied toward securing the permit/any unauthorized changes are made to the site/any unauthorized changes are made in the installation of the system. Improvement Permit with plat valid without expiration ☐ Improvement Permit with site plan valid for sixty months ☒ Authorization to Construct is valid for a period equal to that of Improvement Permit – not to exceed sixty months.

Signed: Vasile Lazar date 5-1-07 Installed by: Ray's Septic Rowan Septic

Improvement Permit by: John E Alexander date 5-1-07 Operation Permit by: Anthony Coburn date 12/3/07

Authorization to Construct by: John E Alexander date 5-1-07 Existing System Inspection by: _____ date _____

HEALTH DEPT. COPY: WHITE OWNER COPY (FINAL): YELLOW OWNER COPY (INITIAL): PINK