4669 II 8896

IREDELL COUNTY HEALTH DEPARTMENT

STATESVILLE 704-878-5305 MOORESVILLE 704-664-5281

IMPROVEMENT PERMIT / CERTIFICATE OF COMPLETION / OPERATION PERMIT / EXISTING SYSTEM INSPECTION

PROPERTY DESCRIPTION NO. 13835 DATE 8/8/94 TAX MAP NO. 10 2A 29 Watershed: ☐ Yes ☑ No

OWNER OR CONTRACTOR D.D. Meadows PHONE: Business 663-4830 Home

ADDRESS 326 Wiggins Rd. Mooresville, NC.

LOCATION Ginger Ln. on (L)

SUBDIVISION BLOCK / SECTION LOT 29 LOT AREA ~1. AC SITE CLASS. P DESIGN FLOW 240 L.T.A.R. .12-.25

Septic Tank: 1000 Gallons; STB 794 Date 7/24/94
Pump Tank: Gallons; PT Date
Pump Make: Model Serial No.
Nitrification Field: No Fields 1 Square Feet 960 Linear Feet 320
No Lines 4 Trench Width 3' Max Trench Bottom Depth 32" Gravel Depth 12"

☑ New System ☐ Repair System Type: I (II) III, IV, V, VI
System Description: CONV - DROPBOXES
Repair System Description:
Maintenance Agreement Required: ☐ Yes ☑ No

☑ House/Mod. Home No. Bedrooms 2
☐ Mobile Home No. Bathrooms 2
☐ Business No. Employees
☐ Other


Water Supply: ☐ Individual ☑ Community ☐ Public

☐ Slab ☑ Crawl Space ☐ Basement w/plumbing ☐ Basement wo/plumbing

Comments:
Useable Spot Site - Keep shallow

Comments:
Installed as shown of Imp. Permit

INITIAL SITE SKETCH

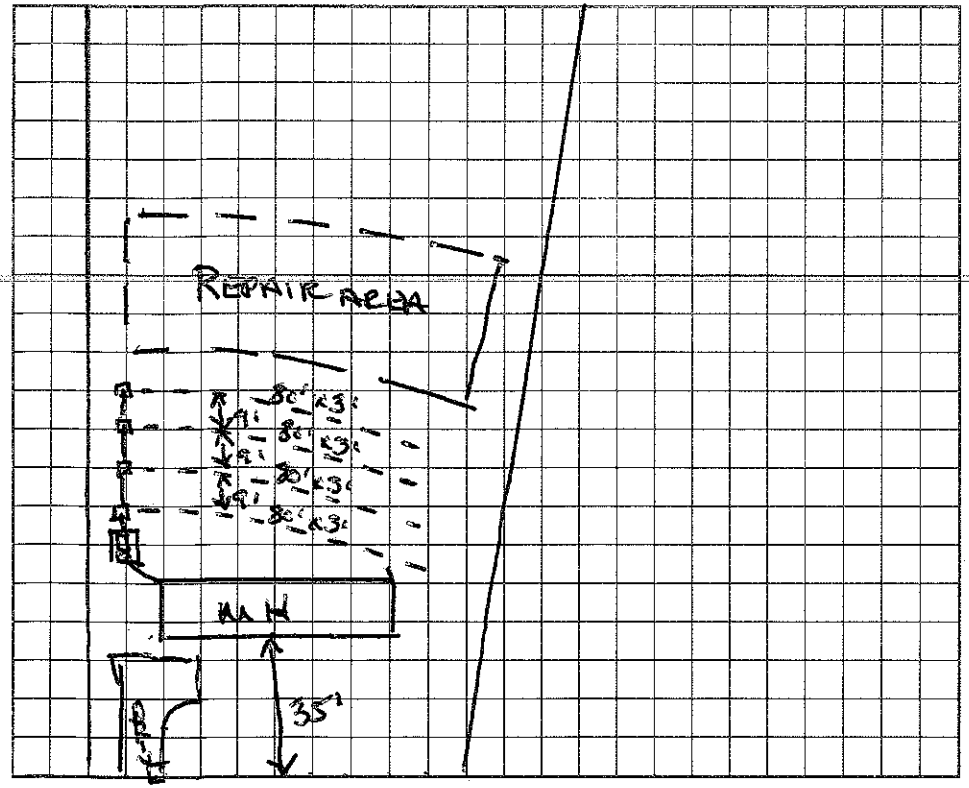

AS BUILT SKETCH

I understand that this permit can be suspended or revoked if any false information is supplied toward securing the permit/any unauthorized changes are made to the site/any unauthorized changes are made in the installation of the system. Improvement Permit is valid for 60 months from date of issuance.

Signed: D D Meadows

Improvement Permit by: Wesley Sparks RS date 8/8/94

Existing System Inspection by: date

Installed by: Larry Beam

Certificate of Completion by: Wesley Sparks RS. date 9/12/94

Operation Permit by: date

HEALTH DEPT. COPY: WHITE INSPECTION COPY (FINAL): GREEN OWNER COPY (FINAL): YELLOW INSPECTION COPY (INITIAL): PINK OWNER COPY (INITIAL): GOLD