IREDELL COUNTY HEALTH DEPARTMENT

Statesville Office (704) 878-5305 | Mooresville Office (704) 660-3625 | PERMIT # 246456

SEPTIC IMPROVEMENT PERMIT / AUTHORIZATION TO CONSTRUCT / OPERATION PERMIT / EXISTING SYSTEM

PIN # 4669-12-1615-178

APPLICANT/OWNER: Tess Clubb | APPLICANT ADDRESS: 303 Cornelius Rd. Mooresville, NC

SITE ADDRESS: 178 Ginger Lane Mooresville, NC | PHONE: 704-677-5278 | ALT. PHONE: —

SITE DIRECTIONS: Rt 21 N from Mooresville → R on Shinnville Rd → L on Ginger → @ end on Right | SAP CONTROLLED: ☐ YES ☒ NO

SUBDIVISION: Meadows Property MHP | SECTION: — | LOT #: — | LOT AREA: 3.46 acres | DESIGN FLOW: 240 GPD | L.T.A.R.: Existing

Septic Tank	(gal)	STB	Date	☐ New System ☐ Repair ☐ Expansion	System Type: I (II) III IV V VI	☒ Residence	No. Bedrooms: 2
Pump Tank	(gal)	PT	Date	System Description:		☐ Business	No. Persons: 4
Pump Make	Model		Serial#	Repair System Description: Existing		☐ Other	No. Employees:
# Nitrification Fields	# Lines		Linear Ft	Maintenance Agreement Required:	☐ YES ☒ NO	☐ Slab	☒ Crawl Space
Trench Width	Trench Bottom Depth(Low side)		Gravel Depth		☒ GRAVITY ☐ PRESSURE	☐ Basement w/plumbing	☐ Basement w/o plumbing


Water Supply: ☐ Private ☐ Public ☐ Community

Existing


Comments / Conditions: Proposed mobile home to NOT have foundation drain.

Recommend having septic tank pumped every 3-5 years. *At time of site visit, system appeared functional. Recommend conservative water use.*

INITIAL SITE SKETCH

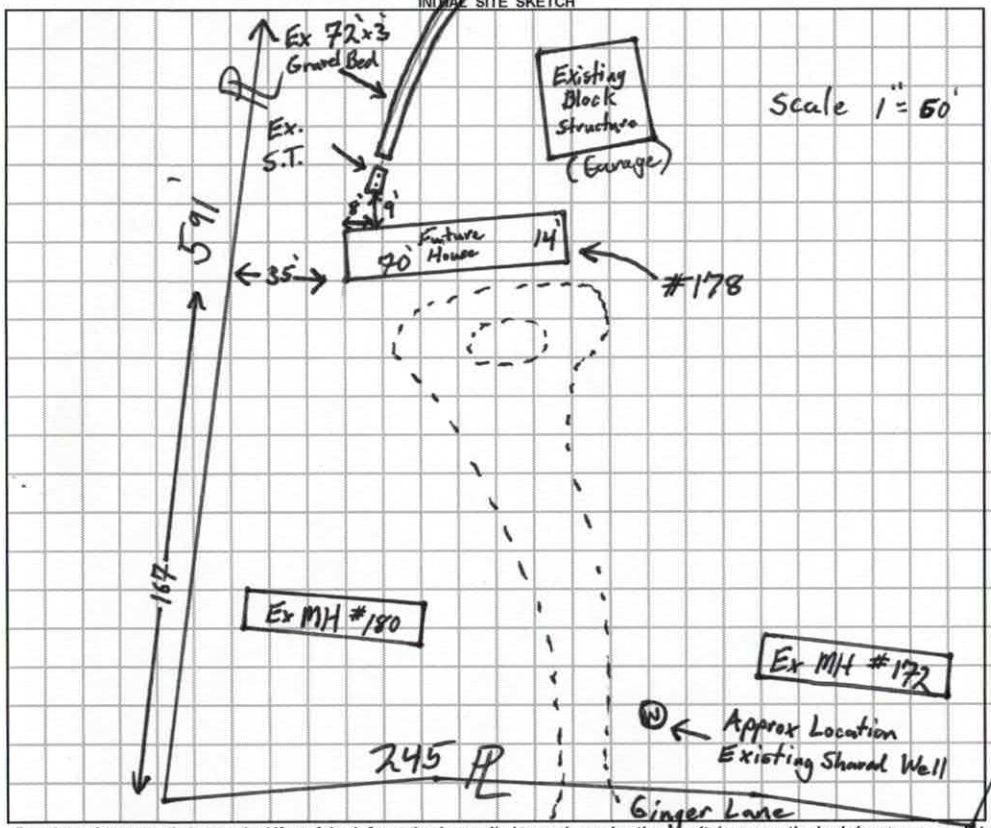

AS BUILT SKETCH

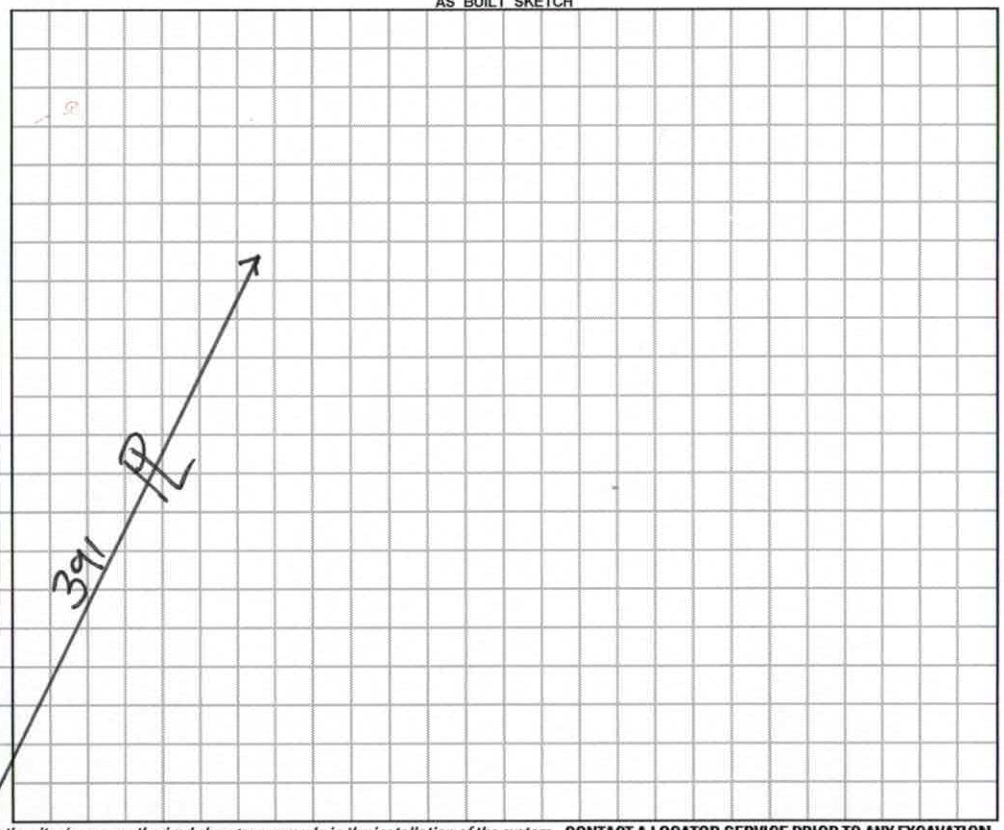

Permit can be suspended or revoked if any false information is supplied toward securing the permit / any unauthorized changes are made to the site / any unauthorized changes are made in the installation of the system. CONTACT A LOCATOR SERVICE PRIOR TO ANY EXCAVATION

☐ IMPROVEMENT PERMIT *with plat valid without expiration.* ☑ IMPROVEMENT PERMIT *with site plan valid for 60 mos.* ☐ AUTHORIZATION TO CONSTRUCT *valid for period equal to IMPROVEMENT PERMIT--not to exceed 60 mo.*

Owner / Applicant Signature: Tess Clubb | Date: | Installed by:

IMPROVEMENT PERMIT by: | Date: | OPERATION PERMIT by: | Date:

AUTHORIZATION TO CONSTRUCT by: | Date: | Existing System Inspected by: Tom Shuck | Date: 8/9/2019

FOR SEPTIC FINAL INSPECTION: CALL 704-664-3703 between 8am-9am the day t[illegible]ection is needed. Be sure to speak with an inpsector to confirm your inspection time.

#2964456
7.9.19
$250.00

APPLICATION MUST BE FILLED OUT COMPLETELY & BE LEGIBLE OR IT WILL NOT BE PROCESSED

Iredell County Health Department – Environmental Health Division

PAGE 1: *APPLICATION FORM*

Application For:
( ) New Well Permit ( ) Well Repair Permit ( ) Well Abandonment
( ) Septic Improvement Permit ( ) Authorization to Construct (✓) Existing System Inspection ( ) Septic System Repair

THE ABOVE PERMIT DOCUMENTS WILL BECOME INVALID IF INFORMATION PROVIDED ON THIS APPLICATION IS FALSIFIED OR CHANGED, OR IF THE SITE IS ALTERED. THE IMPROVEMENT PERMIT IS VALID FOR EITHER 60 MONTHS OR WITHOUT EXPIRATION DEPENDING UPON DOCUMENTATION SUBMITTED. APPLICATION WITH SITE PLAN 60 MONTHS, APPLICATION WITH COMPLETE, SCALED PLAT WITHOUT EXPIRATION. SEE 15A NCAC 18A .1937(f) FOR DETAILS.

Page 2: *Site Plan Worksheet* form MUST accompany this application

The following optional attachments may also be submitted: ( ) Survey Plat, scaled no more than 1 inch = 60 feet
Place an (X) beside whichever is submitted if applicable ( ) Custom Site Plan, scaled no more than 1 inch = 60 feet

Applicant Information: (PRINT CLEARLY)

Applicant Name: Tess Clubb Address: 303 Cornelius Rd. Mooresville NC Zip: 28117
Applicant Email: _____ Phone: 7046775278 Alt. Phone: _____
Owner Name: _____ Address: _____ Zip: _____
Owner Email: _____ Phone: _____ Alt. Phone: _____

Property Information:

Street Address: 178 Ginger lane, Mooresville NC
Subdivision Name: _____ Section/Phase: _____ Lot Number: _____
Driving Directions: _____

Site Development Information: *(check or complete ALL that apply*

(✓) New Single Family Residence
( ) New Multi-Family Residence
( ) Accessory Building
( ) Bedroom(s) Addition
( ) Repair to failing septic system ___ Tank ___ Drain lines Describe Problem: _____
Maximum Number of Bedrooms: 2
Maximum Number of Occupants: 2
( ) Swimming Pool
( ) Other Addition/Structure: _____
Non-Residential Site Development: Type of Business: _____
Square Footage of Building: _____ Max. Number of Employees: _____ Max. Number of Seats/Beds/Other: _____

CHECK FOUNDATION TYPE
(✓) Crawl Space Foundation
( ) Concrete Slab Foundation
( ) Basement with Plumbing
( ) Basement without Plumbing

Water Supply: ( ) Replacement Well – Reason: _____
( ) Multi-connection Well Number of Houses: _____ Number of Persons: _____
( ) New Well ( ) Existing Well (✓) Community Well ( ) City Water ( ) Other Public Water

Desired Septic System Type: *(you may rank in order of preference)* Year existing system installed: _____
( ) No Preference ( ) Alternative (✓) Conventional ( ) Innovative ( ) Modified Conventional ( ) Other: _____

Please answer the following to the best of your ability:
( ) Yes (✓) No Does the site contain any jurisdictional wetlands?
( ) Yes (✓) No Is any non-domestic sewage (i.e. industrial) to be generated?
( ) Yes (✓) No Is the site subject to approval by any other public agency?

I have read this application and certify that the information provided herein is true, complete, and correct. Authorized county and state officials are granted right of entry to conduct necessary inspections to determine compliance with applicable laws and rules. I understand that I am solely responsible for the proper identification and labeling of all property lines and corners and making the site accessible so that a complete site evaluation can be performed.

Signature: Tess Clubb 7/9/19
Property owner or owner's legal representative signature (SIGNATURE REQUIRED) DATE

IREDELL COUNTY DEPARTMENT OF ENVIRONMENTAL HEALTH

DOCUMENTATION TO AUTHORIZE AN OWNER'S LEGAL REPRESENTATIVE

(Check and sign only ONE of the options below)

1. *** APPLICANT AND OWNER ARE THE SAME. *** *(Sign here)* Tess Clubb

Applications for permits require the "signature of the owner or owner's legal representative" (15A NCAC 18A .1937). If the owner does not sign the application himself or herself, they can submit any one of the following documents to designate their legal representative: *Power of Attorney; Real Estate Contract; Estate executor; Bankruptcy trustee; Court ordered guardianship* In the absence of the above documentation, the property owner may provide the local health department with documentation that designates a legal representative. A property owner may:
Complete this form to document his or her legal representative, or provide his or her own form that contains the information in this form. If there are multiple property owners, then all property owners must sign the form that designates a legal representative.
By signing a form that designates a legal representative for purposes of 15A NCAC 18A .1937, the property owner authorizes that representative to act on their behalf in matters pertaining to the application and permitting process, including signing or receiving any application, document or permit. The owner retains full responsibility to meet all permit conditions specified by the local health department.

2. I, Tess Clubb, am the legal owner(s) of the property located at 148 Ginger lane, identified as

PIN (Parcel Identification Number)_____, located in Iredell County, North Carolina.

I do hereby authorize **(print legal representative/company name)** Clubb Realty, to act as an agent on my behalf in applying for/signing/obtaining any of the documents described below.

- Application for Improvement Permit (IP) / Authorization to Construct (AC)
- Improvement Permit (IP) / Authorization to Construct (AC)
- Application for soil-site evaluation (new/repair)
- Application/permit for private drinking water well/well abandonment
- Application for Compliance Inspection

I agree to abide by all decisions and/or conditions between the legal representative acting on my behalf and the Iredell County Department of Public Health, Environmental Health Division.


Tess Clubb
Signature of Owner(s)

7/9/19
Date

Mooresville - Environmental Health
ronda.hart@co.iredell.nc.us
Fax: 704-662-3239
610 E. Center Avenue, Mooresville, NC 28115

Statesville - Environmental Health
adrienne.shea@co.iredell.nc.us
Fax: 704-871-3483
349 N. Center Street, Statesville, NC 28677

178 Ginger Lane

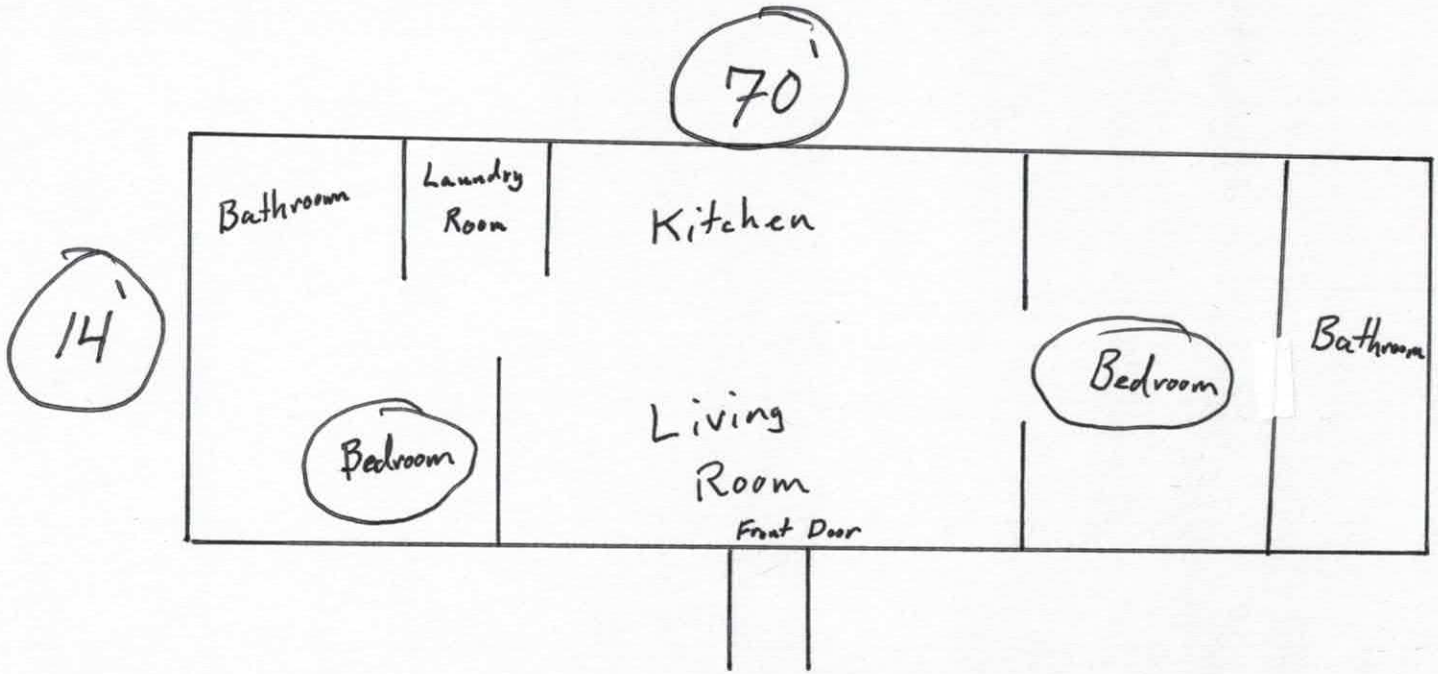

Acknowledgement Of
Plans Submittal ONLY!
Jess Clark Date
Tom Shuck Date 8/9/2019

IREDELL COUNTY

PO Box 788
349 North Center St.
Statesville, NC 28677

APPLICATION NUMBER
246456
Issue Date: 07/09/2019

ZONING PERMIT

Residential

Parcel Number	Street Address	Jurisdiction
4669121615.000	178 GINGER, MOORESVILLE, NC 28115	IREDELL COUNTY

Owner Information	Applicant Information
Owner: CLOWERS EDWARD E+CATHERINE L	Applicant: CLUBB REALTY
Address: 13325 NC HIGHWAY 801	Address: 303 CARNELIUS RD
MT ULLA, NC 28125	MOORESVILLE, NC 28117
Phone:	Phone: 704-677-5278

Use Requested	Zone Code
	RA

Lot Acreage	F Setback	B Setback	L Setback	R Setback	Watershed	Flood Zone
3.460	20.00	25.00	25.00	15.00	NOT	X

Remarks:

REQUIREMENTS FOR ALL SINGLEWIDE MOBILE HOMES Must meet requirement R10 of the LDC. Must remove the towing apparatus, if it cannot be removed, it shall be screened; Must have a continuous underpinning; Must have 36 square foot front porch constructed within 12 inches of the floor elevation; Must have approved steps at all other secondary entrances and exits; Must face front property line and be no less than 20 degrees from parallel to the front property line. Original home must be removed before Certificate of Occupancy can be approved.

The applicant certifies that there are no deed restrictions, contractual agreements or governmental regulations of any kind that interfere with or prohibit the use of the property or the use for which this permit is requested. The applicant further acknowledges that enforcement of deed restrictions, plat conditions and other contractual agreements will not be undertaken by Iredell County and is the sole responsibility of the affected parties.

Applicant: _____ Date: _____

Permit Number	184408	TOTAL FEES:	$ 77.25