ICHD - ENVIRONMENTAL HEALTH DIVISION

Statesville Office (704) 878-5305 | Mooresville Office (704) 660-3625 | PERMIT # 2023-26406

SEPTIC: IMPROVEMENT PERMIT / AUTHORIZATION TO CONSTRUCT / OPERATION PERMIT / EXISTING SYSTEM

PIN # 4669 -- 12 -- 3116

APPLICANT/OWNER: Tess Club | APPLICANT ADDRESS: 303 Cornelius Rd, Mooresville

SITE ADDRESS: 163 Ginger Ln, Mooresville 28115 | PHONE: 704-677-5278 | ALT. PHONE


SITE DIRECTIONS: Shinnville - Ginger | SAP CONTROLLED: ☐ YES ☐ NO

SUBDIVISION: Meadows Property MHP | SECTION: - | LOT # - | LOT AREA: 0.809 acres | DESIGN FLOW: 360 gpd | L.T.A.R.: Ex

Septic Tank	EX (gal)	STB	Date	☐ New System ☐ Repair ☐ Expansion	System Type: I (II) III IV V VI	☒ Residence	No. Bedrooms	3	Water Supply
Pump Tank	(gal)	PT	Date	System Description:	Gravel BED	☐ Business	No. Persons	6	☒ Private
Pump Make	Model		Serial #	Repair System Description:	EXISTING	☐ Other	No. Employees		☐ Public
# Nitrification Fields	EX # Lines EX		Linear Ft EX	Maintenance Agreement Required:	☐ YES ☒ NO	☐ Slab	☒ Crawl Space		☐ Community
Trench Width	EX Trench Bottom Depth(Low side)	EX	Gravel Depth EX		☒ GRAVITY ☐ PRESSURE	☐ Basement w/plumbing		☐ Basement w/o plumbing	

Comments / Conditions: System appeared to be working at time of inspection.

INITIAL SITE SKETCH

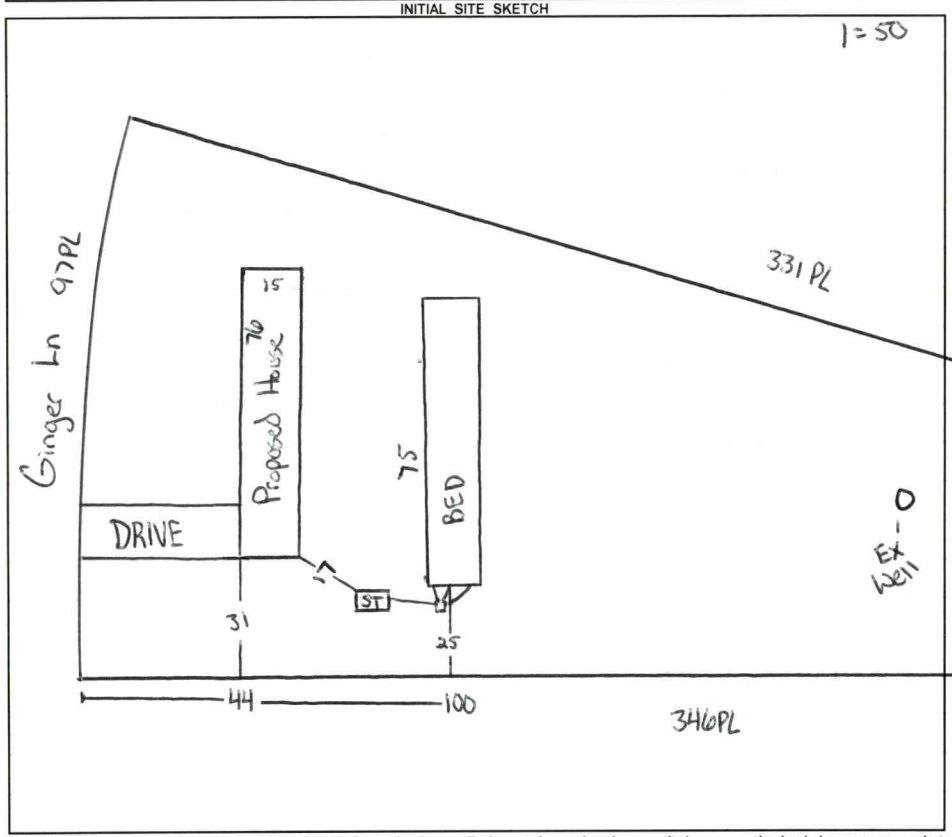

AS BUILT SKETCH

FOR SEPTIC FINAL INSPECTION CALL: 704-664-3703 between 8am-9am the day the inspection is needed. Be sure to speak with an inspector to confirm your time.

Permit can be suspended or revoked if any false information is supplied toward securing the permit / any unauthorized changes are made to the site / any unauthorized changes are made in the installation of the system. **CONTACT A LOCATOR SERVICE PRIOR TO ANY EXCAVATION**

☐ **IMPROVEMENT PERMIT** ***with plat*** *valid without expiration.* ☐ **IMPROVEMENT PERMIT** ***with site plan*** *valid for 60 mos.* ☐ **AUTHORIZATION TO CONSTRUCT** *valid for period equal to IMPROVEMENT PERMIT--not to exceed 60 mo.*

Owner / Applicant Signature: _____ Date: _____ Installed by: _____


IMPROVEMENT PERMIT by: _____ Date: _____ OPERATION PERMIT by: _____ Date: _____

AUTHORIZATION TO CONSTRUCT by: _____ Date: _____ Existing System Inspected by: Cory Wil Date: 6/14/23

FOR SEPTIC FINAL INSPECTION: CALL 704-664-3703 between 8am-9am the day the inspection is needed.

Item	Date	Initials
Drain Lines Checked		
Tanks Checked		
Pressure Manifold or Valve Box Checked		
Pressure Head Set		
Electrical Checked		
Floats Set		
Alarm Checked		
Maintenance Contract Needed? Y / N		
Comments:		

Repairs Only	
	State Code
Failing System Code	
Type of Distribution	G or P
Type of Failure/Malfunction	
Primary Cause of Failure/Malfunction	
Age of System? _____	
Initial or Repair? _____	

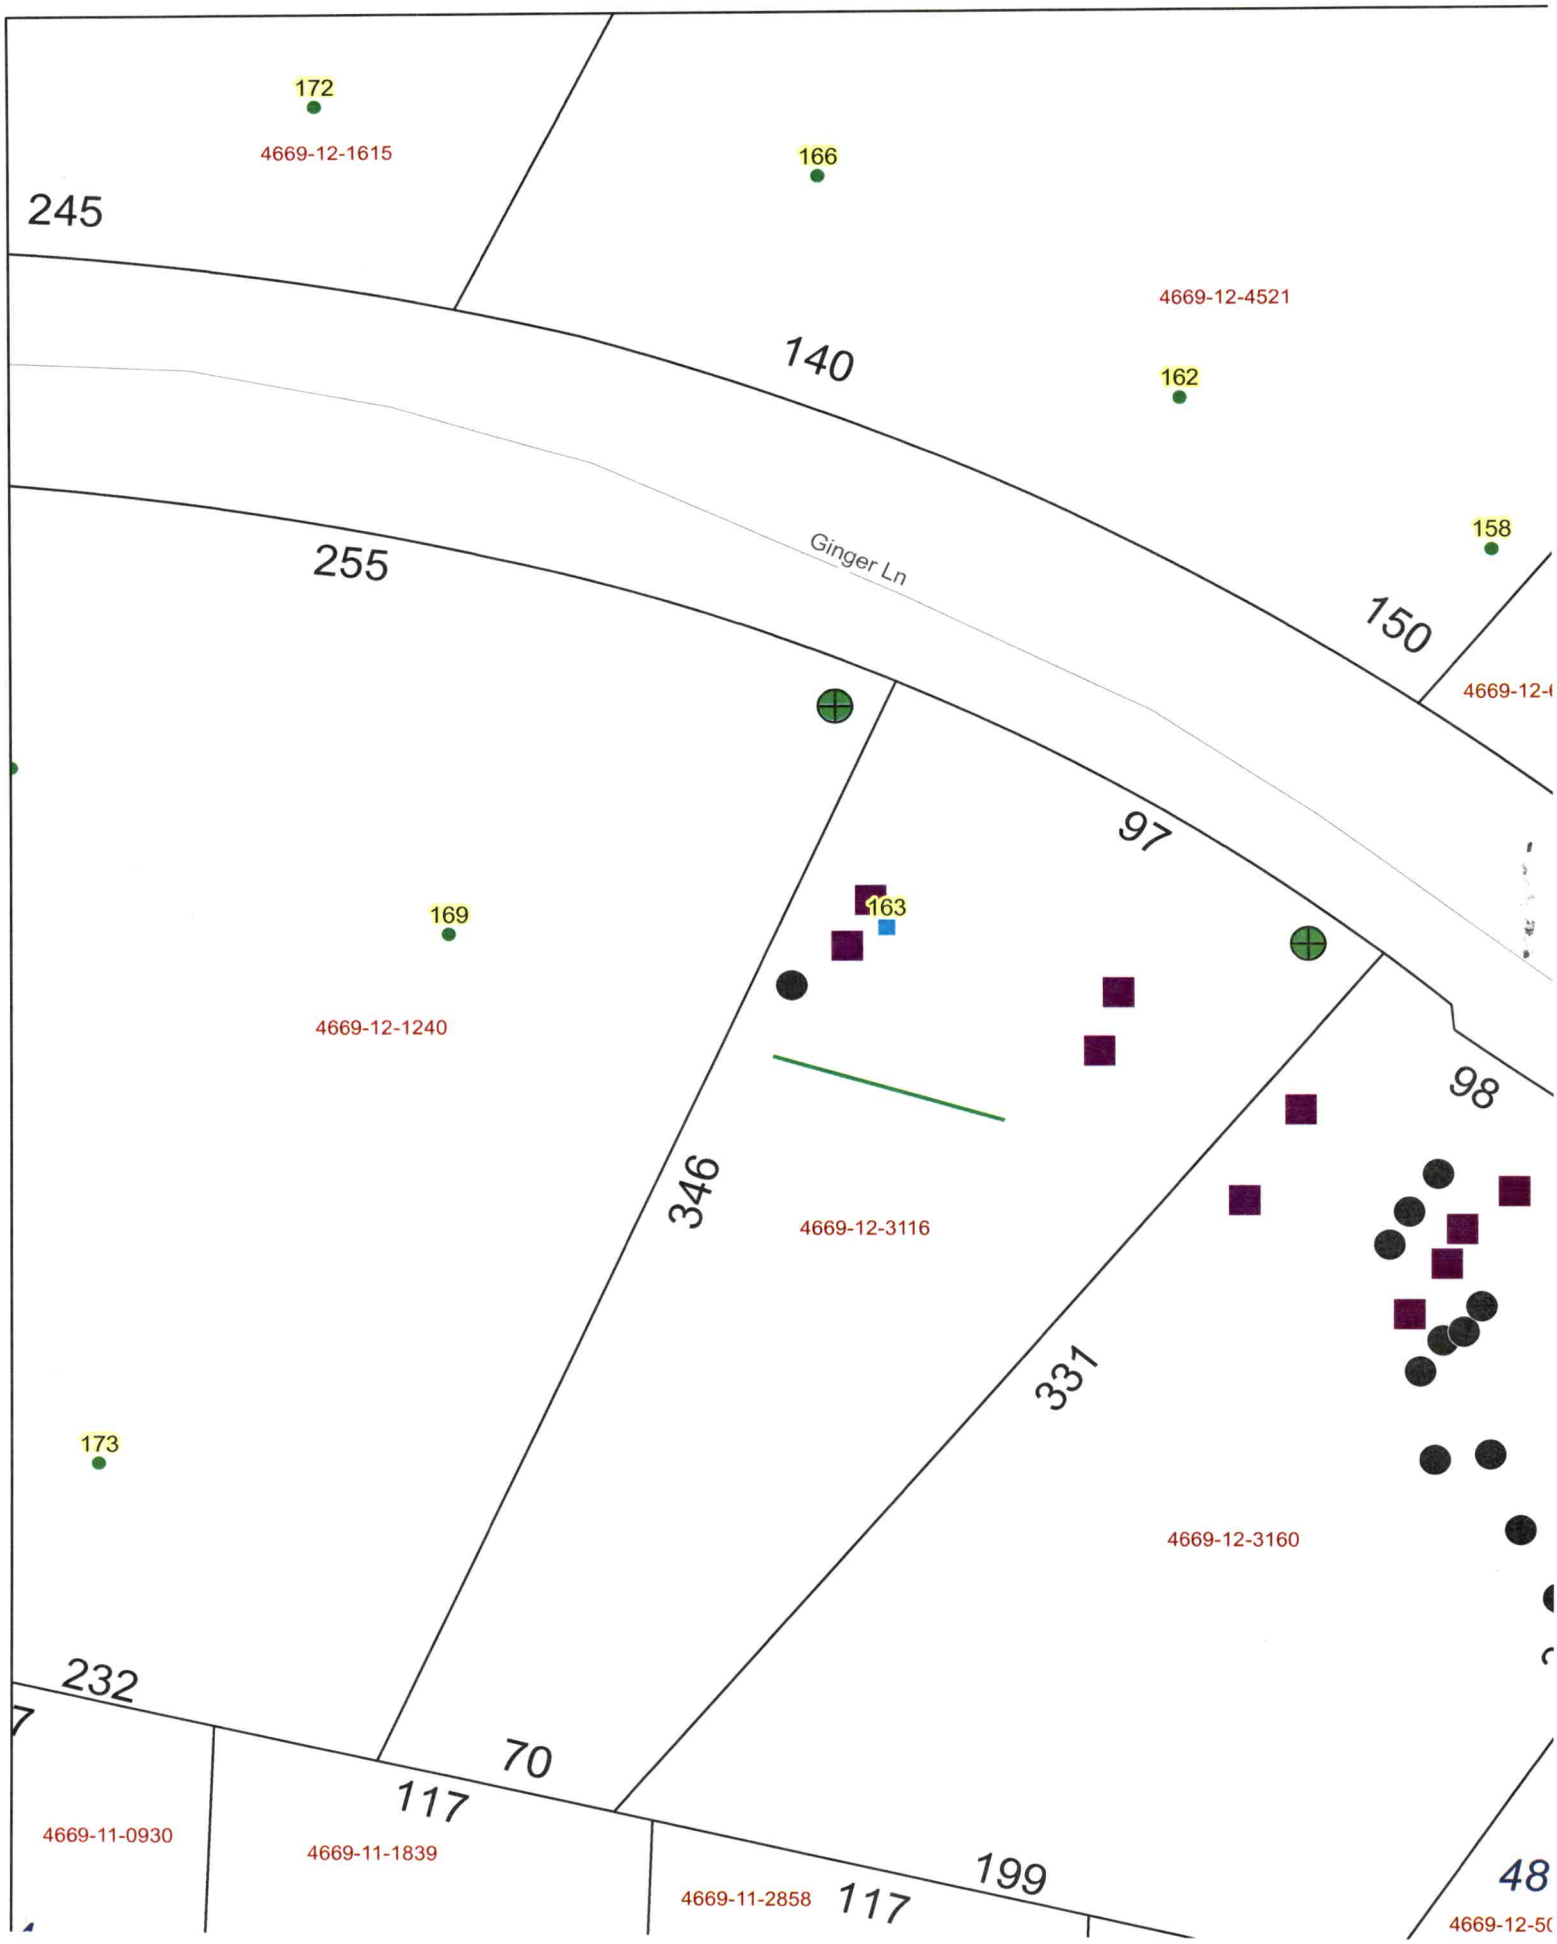
172
4669-12-1615
166
245
4669-12-4521
140
162
158
Ginger Ln
255
150
4669-12-
97
169
163
4669-12-1240
98
346
4669-12-3116
331
173
4669-12-3160
232
70
117
4669-11-0930
4669-11-1839
4669-11-2858
117
199
48
4669-12-5