IREDELL COUNTY HEALTH DEPARTMENT

STATESVILLE 704-878-5305 MOORESVILLE 704-664-5281

IMPROVEMENT PERMIT / AUTHORIZATION TO CONSTRUCT / OPERATION PERMIT / EXISTING SYSTEM INSPECTION

PERMIT# 105087 PIN# ~~4669-12-5004~~ 4669125063 DATE 3/12/02

OWNER OR CONTRACTOR Donald G. Meadows PHONE: Business _____ Home _____

ADDRESS 147 Ginger Ln. Mooresville NC 28117

LOCATION 115 N, TR Shinnville / TL Ginger Ln on Lft 147 Ginger Ln.

SUBDIVISION _____ BLOCK / SECTION _____ LOT _____ LOT AREA Prof 2.27ac SITE CLASS PS DESIGN FLOW 240 L.T.A.R. _____

Septic Tank: Existing Gallons; STB _____ Date _____

Pump Tank: _____ Gallons; PT _____ Date _____

Pump Make: _____ Model _____ Serial No. _____

Nitrification Field: No Fields ___ Square Feet ~~Existing~~ Linear Feet _____

No Lines _____ Trench Width Existing Max Trench Bottom Depth _____ Gravel Depth _____

~~New System~~ ☐ Repair System Type: I (II) III. IV. V. VI

System Description: Existing Conventional

Repair System Description: Conventional

Maintenance Agreement Required: ☐ Yes ☒ No

☐ House/Mod. Home No. Bedrooms 2

☒ Mobile Home No. Bathrooms 2

☐ Business No. Employees ___

☐ Other _____


☐ Slab ☒ Crawl Space ☐ Basement w/plumbing ☐ Basement wo/plumbing

Water Supply: ☒ Individual ☐ Public ☐ Community


Comments:/Conditions:

Comments:/Conditions:

INITIAL SITE SKETCH

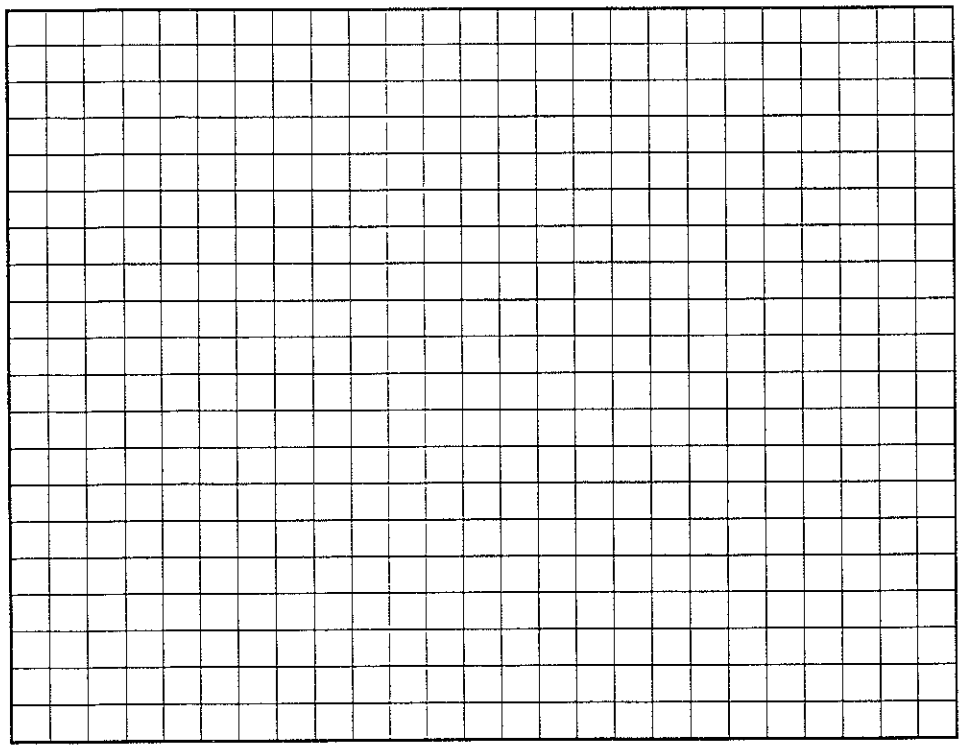

AS BUILT SKETCH

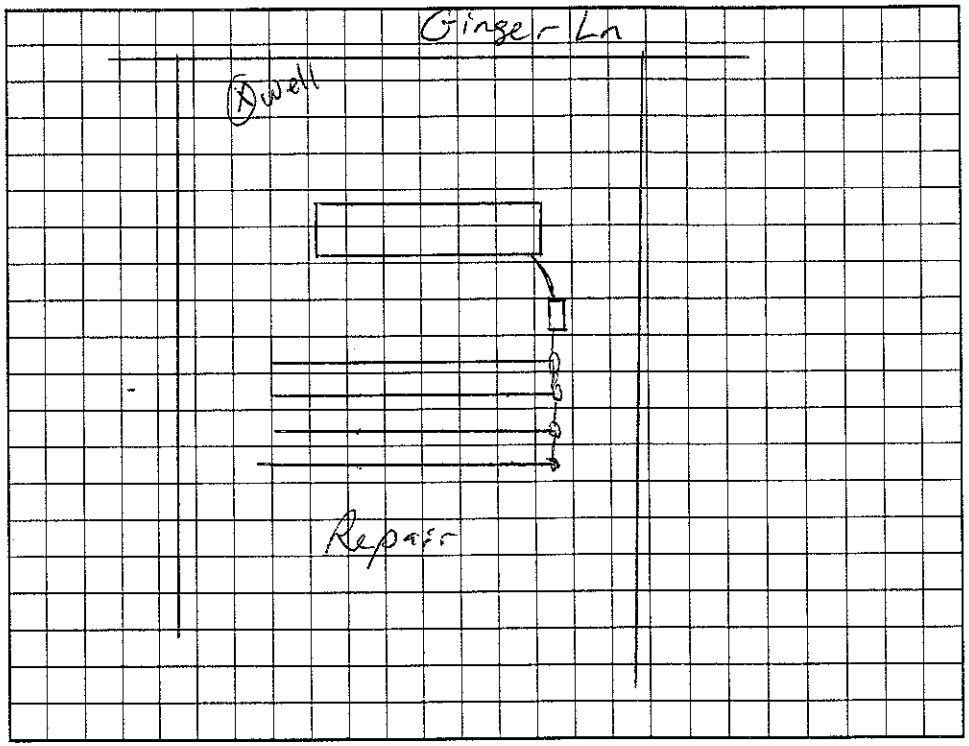

Permit can be suspended or revoked if any false information is supplied toward securing the permit/any unauthorized changes are made to the site/any unauthorized changes are made in the installation of the system. Improvement Permit with plat valid without expiration. Improvement Permit with site plan valid for sixty months. Authorization to Construct is valid for a period equal to that of Improvement Permit – not to exceed sixty months.

Signed: _____ date 3-18-2002 Installed by: _____

Improvement Permit by: _____ date _____ Operation Permit by: _____ date _____

Authorization to Construct by: _____ date _____ Existing System Inspection by: _____ RS date 3/12/02

HEALTH DEPT. COPY: WHITE OWNER COPY (FINAL): YELLOW OWNER COPY (INITIAL): PINK