IREDELL COUNTY HEALTH DEPARTMENT

Authorization to Construct

4669126405

STATESVILLE 704-878-5305 MOORESVILLE 704-664-5281

IMPROVEMENT PERMIT / ~~CERTIFICATE OF COMPLETION~~ / OPERATION PERMIT / EXISTING SYSTEM INSPECTION

PROPERTY DESCRIPTION NO. 24453 DATE 8/6/96 TAX MAP NO. 1Q 2A 29 Watershed: ☐ Yes ☒ No

OWNER OR CONTRACTOR Dalton Smallwood PHONE: Business _____ Home 492-0585

ADDRESS 1799 Shearer Rd. Davidson, NC. 28036

LOCATION Shumcke Rd TL Ginger Ln. on (R) just before ground starts

SUBDIVISION _____ BLOCK / SECTION _____ LOT 29A LOT AREA ~1 ac SITE CLASS PS DESIGN FLOW 360 L.T.A.R. .35

Septic Tank: 1000 Gallons; STB 794 Date 3/1/96

Pump Tank: _____ Gallons; PT _____ Date _____

Pump Make: _____ Model _____ Serial No. _____

Nitrification Field: No Fields 1 Square Feet 1028 Linear Feet 345

No Lines 4 Trench Width 36" Max Trench Bottom Depth 36" Gravel Depth 12"

☒ New System ☐ Repair System Type: I, (II), III, IV, V, VI

System Description: CONV - DIST BOX

Repair System Description: SAME

Maintenance Agreement Required: ☐ Yes ☒ No

☐ House/Mod. Home No. Bedrooms 3

☒ Mobile Home No. Bathrooms 2.5

☐ Business No. Employees ____

☐ Other _____


☐ Slab ☒ Crawl Space ☐ Basement w/plumbing ☐ Basement wo/plumbing

Water Supply: ☒ Individual ☐ Community ☐ Public

Comments:

Comments:

INITIAL SITE SKETCH

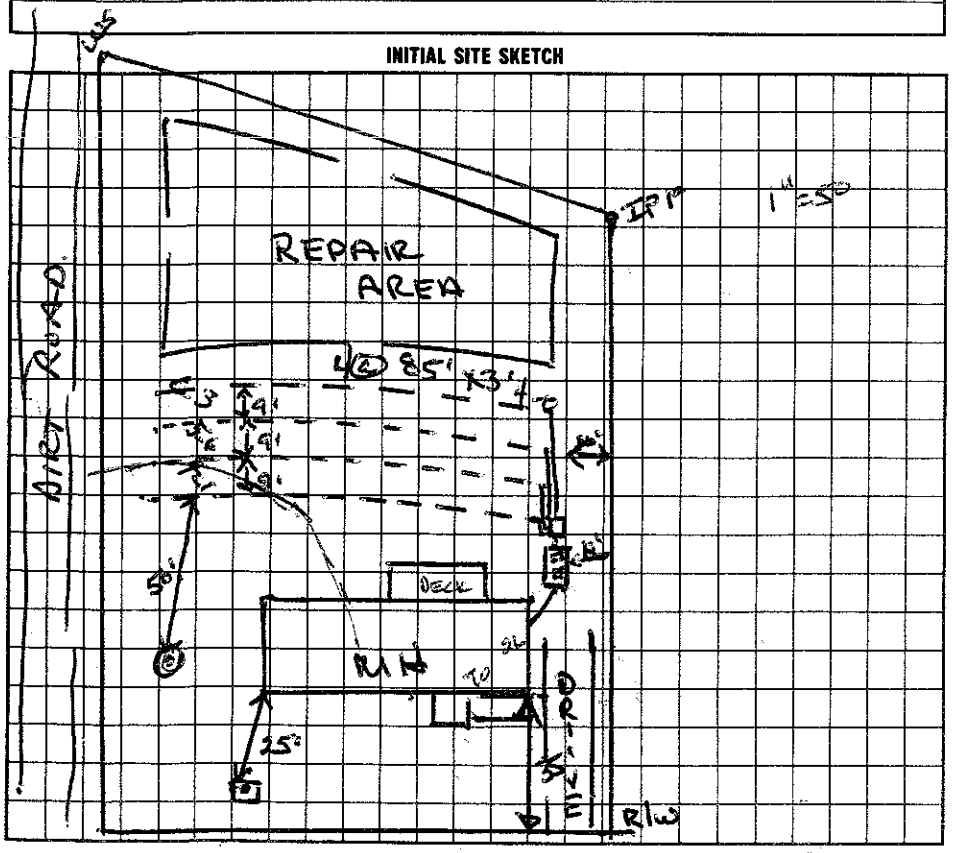

AS BUILT SKETCH

I understand that this permit can be suspended or revoked if any false information is supplied toward securing the permit/any unauthorized changes are made to the site/any unauthorized changes are made in the installation of the system.

Signed: Dalton Smallwood Authorization to Construct valid 60 months. Installed by: Julian Bowles

Improvement Permit by: Wesley Sparks R.S. date 8/6/96 Certificate of Completion by: _____ date _____

Existing System Inspection by: Wesley Sparks R.S. date 8/6/96 Operation Permit by: Wesley Sparks R.S. date 10/25/96

HEALTH DEPT. COPY: WHITE INSPECTION COPY (FINAL): GREEN OWNER COPY (FINAL): YELLOW INSPECTION COPY (INITIAL): PINK OWNER COPY (INITIAL): GOLD