4669140543

# IREDELL COUNTY HEALTH DEPARTMENT

STATESVILLE 704-878-5305 MOORESVILLE 704-664-5281

## IMPROVEMENT PERMIT / CERTIFICATE OF COMPLETION / OPERATION PERMIT / EXISTING SYSTEM INSPECTION

PROPERTY DESCRIPTION NO. 18975 DATE 8/31/94 TAX MAP NO. 4D 2 A 10 Watershed: ☐ Yes ☒ No

OWNER OR CONTRACTOR Terry B. Sims PHONE: Business _____ Home 664-5993

ADDRESS Rt 2 Box 628 Mooresville, NC 28115

LOCATION Springdale Dr. - Shumiller Rd. (L) Springdale to 8th lot on (R)

SUBDIVISION Springdale BLOCK / SECTION _____ LOT 8 LOT AREA 1.9 AC SITE CLASS. P DESIGN FLOW 360 L.T.A.R. .3

Septic Tank: 1000 Gallons; STB 794 Date 9/12/94

Pump Tank: _____ Gallons; PT _____ Date _____

Pump Make _____ Model _____ Serial No. _____

Nitrification Field: No Fields 1 Square Feet 1200 Linear Feet 400

No Lines 4 Trench Width 36" Max Trench Bottom Depth 30-32" Gravel Depth 12"

☒ New System ☐ Repair System Type: I, (II), III, IV, V, VI

System Description: CONV - DIST BOX

Repair System Description: _____

Maintenance Agreement Required: ☐ Yes ☒ No

☒ House/Mod. Home No. Bedrooms 3

☐ Mobile Home No. Bathrooms 2

☐ Business No. Employees _____

☐ Other _____


☐ Slab ☒ Crawl Space ☐ Basement w/plumbing ☐ Basement wo/plumbing

Water Supply: ☒ Individual ☐ Community ☐ Public

Comments: Lines on slope contour in direction shown.

Comments: Installed as shown on Imp. Permit

INITIAL SITE SKETCH

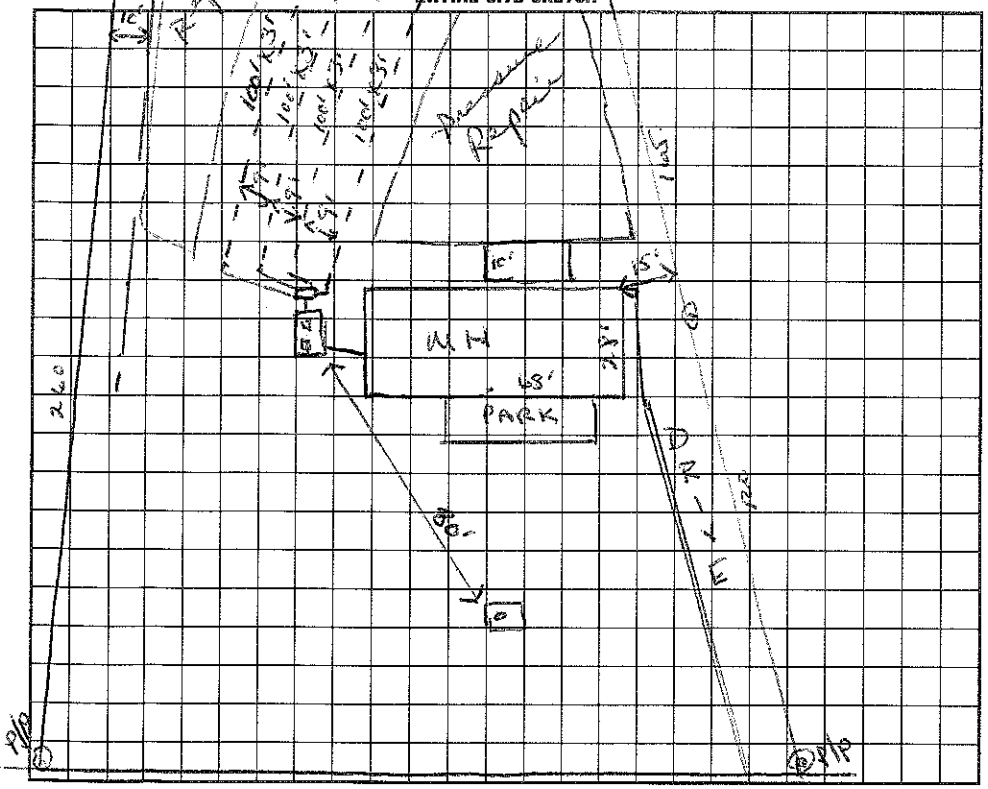


AS BUILT SKETCH

I understand that this permit can be suspended or revoked if any false information is supplied toward securing the permit/any unauthorized changes are made to the site/any unauthorized changes are made in the installation of the system. Improvement Permit is valid for 60 months from date of issuance. SPRINGDALE DR.

Signed: X Terry B. Sims

Improvement Permit by: Wesley Sparks R.S. date 8/31/94

Existing System Inspection by: _____ date _____

Installed by: E J Enviro

Certificate of Completion by: Wesley Sparks R.S. date 11/8/94

Operation Permit by: _____ date _____

HEALTH DEPT. COPY: WHITE INSPECTION COPY (FINAL): GREEN OWNER COPY (FINAL): YELLOW INSPECTION COPY (INITIAL): PINK OWNER COPY (INITIAL): GOLD