4669142418

IREDELL COUNTY HEALTH DEPARTMENT

STATESVILLE 704-878-5305 MOORESVILLE 704-664-5281

IMPROVEMENT PERMIT / CERTIFICATE OF COMPLETION / OPERATION PERMIT / EXISTING SYSTEM INSPECTION

PROPERTY DESCRIPTION NO. Repair DATE 4/8/96 TAX MAP NO. Watershed: ☐ Yes ☑ No

OWNER OR CONTRACTOR Ricky Scott PHONE: Business 278-3738 Home

ADDRESS 162 Springdale Rd

LOCATION Shiloville Rd - TL Springdale - 4th house on Rt.

SUBDIVISION Springdale BLOCK / SECTION LOT 7 LOT AREA SITE CLASS. DESIGN FLOW L.T.A.R.

Septic Tank: 1000 Gallons; STB Date

Pump Tank: Gallons; PT Date

Pump Make: Model Serial No.

Nitrification Field: No Fields 1 Square Feet 765 Linear Feet 255

No Lines 4 Trench Width 36" Max Trench Bottom Depth 36" Gravel Depth N/A

☐ New System ☑ Repair System Type: I, II, (III), IV, V, VI

System Description: Gravity Chambers

Repair System Description:

Maintenance Agreement Required: ☐ Yes ☐ No

☑ House/Mod. Home No. Bedrooms 3

☐ Mobile Home No. Bathrooms 2

☐ Business No. Employees

☐ Other


☐ Slab ☐ Crawl Space ☐ Basement w/plumbing ☐ Basement wo/plumbing

Water Supply: ☑ Individual ☐ Community ☐ Public


Comments:

Comments: Approved for 280' Chambers

INITIAL SITE SKETCH

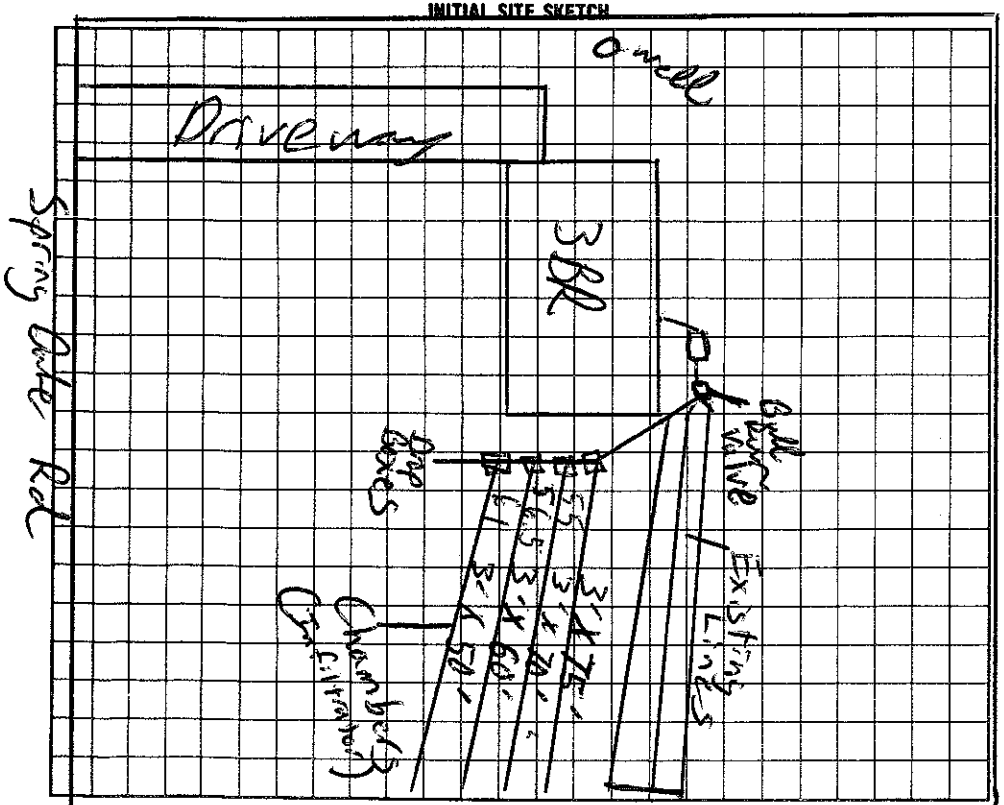

AS BUILT SKETCH

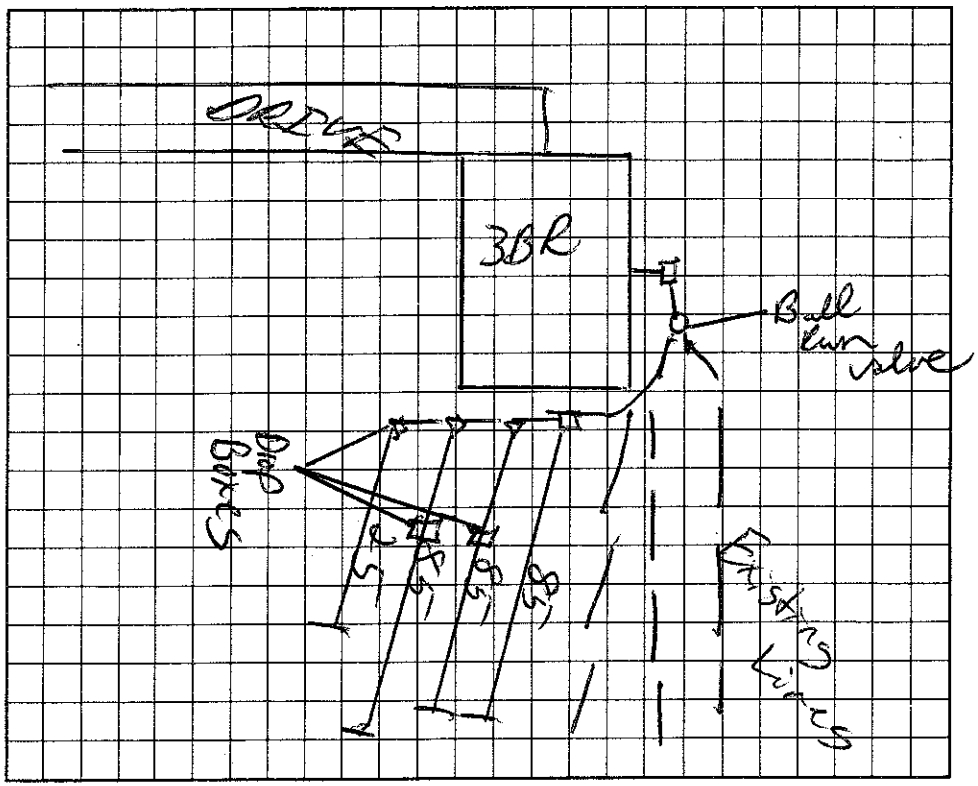

I understand that this permit can be suspended or revoked if any false information is supplied toward securing the permit/any unauthorized changes are made to the site/any unauthorized changes are made in the installation of the system.

Signed: Ricky Scott

Improvement Permit by: C. Bradsteen EHSS date 4/8/96

Existing System Inspection by: C. Bradsteen EHSS date 4/15/96

Installed by: E. Elder

Certificate of Completion by: date

Operation Permit by: C. Bradsteen EHSS date 4/17/96

HEALTH DEPT. COPY: WHITE INSPECTION COPY (FINAL): GREEN OWNER COPY (FINAL): YELLOW INSPECTION COPY (INITIAL): PINK OWNER COPY (INITIAL): GOLD