IREDELL COUNTY HEALTH DEPARTMENT

STATESVILLE 704-878-5305 MOORESVILLE 704-664-5281

IMPROVEMENT PERMIT / AUTHORIZATION TO CONSTRUCT / OPERATION PERMIT / EXISTING SYSTEM INSPECTION

PERMIT # 153291 PIN # 4669-14-8275 DATE 10-27-08

OWNER or APPLICANT Kyle Ringwald PHONE: Business 704-662-3272 Home: 704-658-9395

OWNER or APPLICANT ADDRESS 8131 Springdale Dr.

LOCATION / DIRECTIONS Shinnville, TL Springdale, on L

SUBDIVISION Springdale BLOCK / SECTION — LOT # 27 LOT AREA .504 AC DESIGN FLOW 360 L.T.A.R. ~.4

Septic Tank ____ Gallons: STB ____ Date ____
Pump Tank ____ Gallons: PT ____ Date ____
Pump Make ____ Model Existing Serial # ____
Nitrification Field No Fields ____ No Lines ____ Linear Feet ____
Trench Width ____ Max. Trench Bottom Depth ____ Gravel Depth ____

☐ New System ☐ Repair ☐ Expansion System Type I II III IV V VI
System Description: Gravity Conventional
Repair System Description: Same
Maintenance Agreement Required ☐ YES ☒ NO
☒ GRAVITY ☐ PRESSURE


☒ Residence No. Bedrooms 3
☐ Business No. Persons ____
☐ Other No. Employees ____
☐ Slab ☒ Crawl Space
☐ Basement w/plumbing ☐ Basement w/o plumbing

Water Supply: ☒ Private ☐ Public ☐ Community


Comments / Conditions 1) Proposed garage should be 5' from septic lines

Comments / Conditions

INITIAL SITE SKETCH

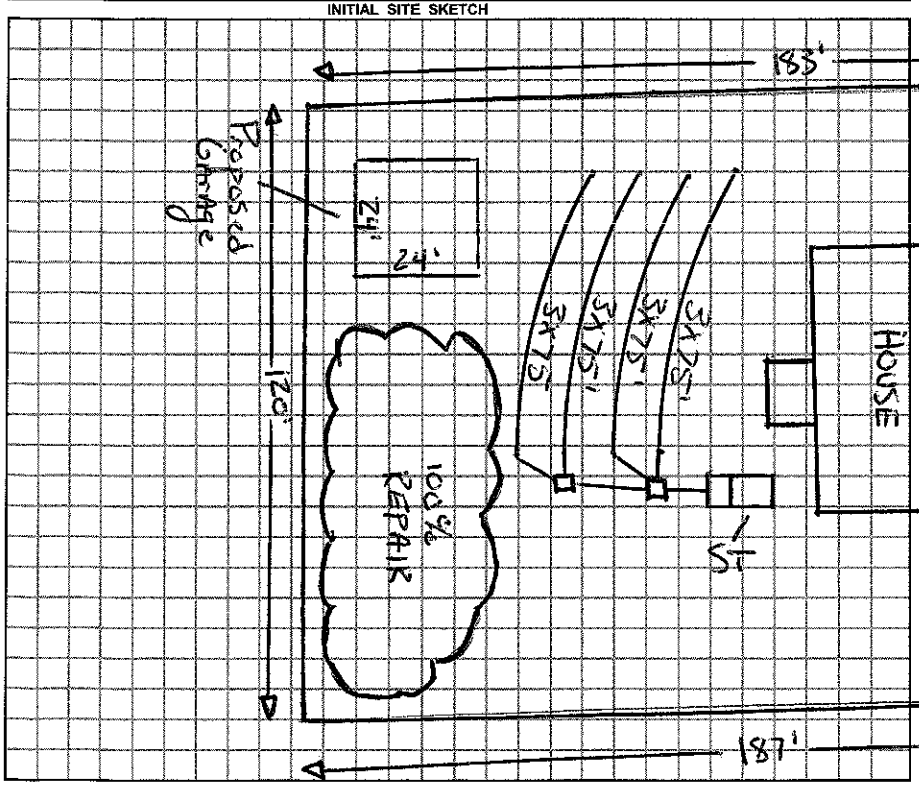

AS BUILT SKETCH

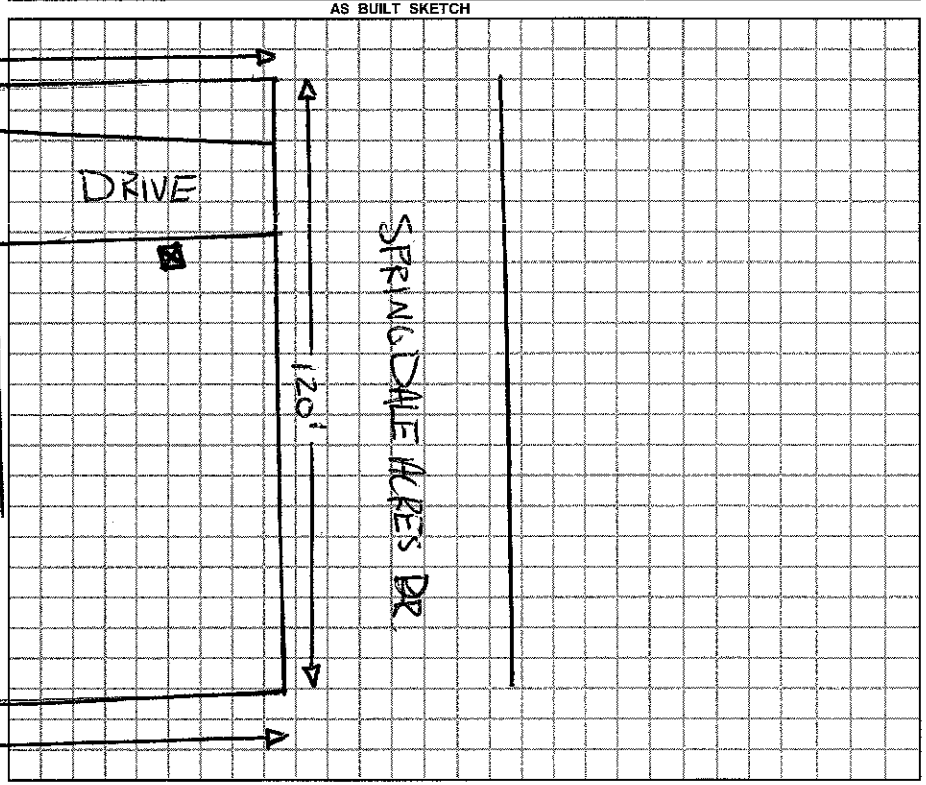

Permit can be suspended or revoked if any false information is supplied toward securing the permit / any unauthorized changes are made to the site / any unauthorized changes are made in the installation of the system.

☐ *IMPROVEMENT PERMIT w/ plat valid without expiration.* ☐ *IMPROVEMENT PERMIT w / site plan valid for 60 mos.* ☐ *AUTHORIZATION TO CONSTRUCT valid for period equal to IMPROVEMENT PERMIT-not to exceed 60 mo.*

Owner / Applicant Signature: Ronald Kyle Ringwald Date 10-27-08 Installed by: ____

Improvement Permit by: ____ Date ____ Operation Permit by: ____ Date: ____

Authorization to Construct by: ____ Date ____ Existing System Inspected by: [signature] Date: 10-27-08

YOU SHOULD CONTACT A LOCATOR SERVICE PRIOR TO ANY EXCAVATION.

WHITE COPY Environmental Health YELLOW COPY (Final) Owner / Applicant PINK COPY (Initial) Owner / Applicant