IREDELL COUNTY HEALTH DEPARTMENT

STATESVILLE 704-878-5305 MOORESVILLE 704-664-5281

IMPROVEMENT PERMIT / AUTHORIZATION TO CONSTRUCT / OPERATION PERMIT / EXISTING SYSTEM INSPECTIO

PERMIT# 112838 PIN# 4669200547 DATE 6/5/03

OWNER OR CONTRACTOR Gary Overcash PHONE: Business Home 704 664-7182

ADDRESS 361 Shinnville Rd Mooresville NC 28115

LOCATION Hwy 21/115 N TR Shinnville Rd on left just before Pond View

SUBDIVISION — BLOCK / SECTION — LOT — LOT AREA — SITE CLASS. PS DESIGN FLOW 240gpd L.T.A.R. .3

Septic Tank: Existing (1000) Gallons; STB — Date —
Pump Tank: — Gallons; PT — Date —
Pump Make: — Model — Serial No. —
Nitrification Field: No Fields 1 Square Feet 840 Linear Feet 280
No Lines 3 Trench Width 36" Max Trench Bottom Depth 36 Gravel Depth 12"

☒ New System ☐ Repair System Type: I (II) III IV V VI
System Description: Addition Gravity Conventional
Repair System Description: —
Maintenance Agreement Required: ☐ Yes ☐ No


☒ House/Mod. Home No. Bedrooms 2
☐ Mobile Home No. Bathrooms 2
☐ Business No. Employees —
☐ Other —
☐ Slab ☒ Crawl Space ☐ Basement w/plumbing ☐ Basement wo/plumbing

Water Supply: ☒ Individual ☐ Public ☐ Community

Comments:/Conditions: Use existing Septic tank (ST) Run new Supply line from ST to new drainfield. (stay 5' from PL) Install 3 Conventional drain lines (varying lengths)


Comments:/Conditions: Keep Septic System at least 10' from PL & 15' from pool.

INITIAL SITE SKETCH

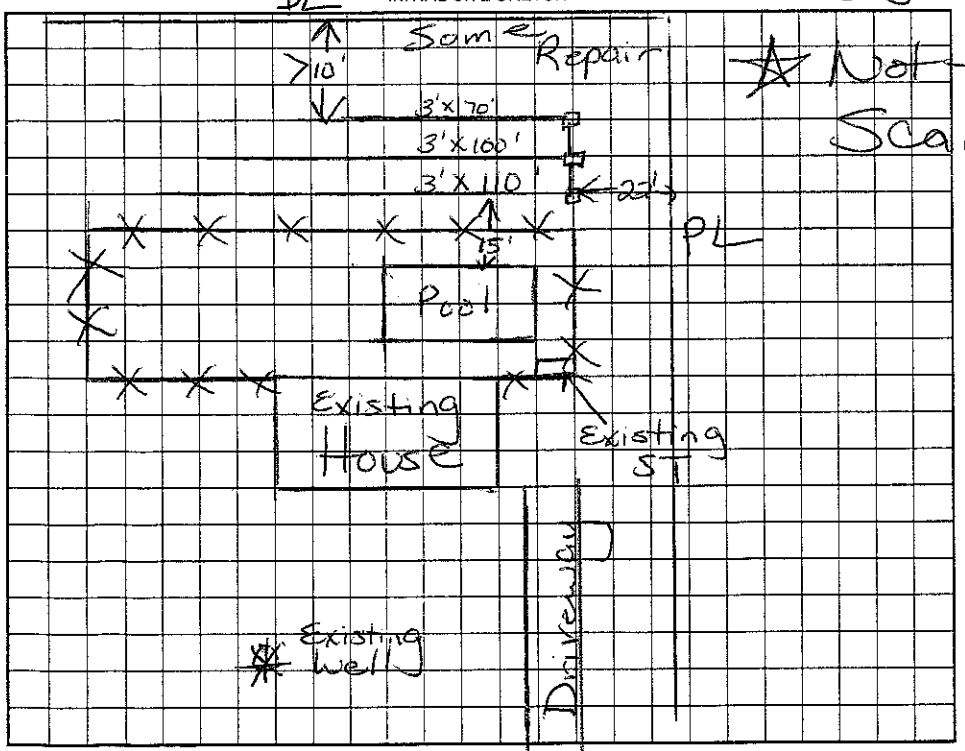

Not to Scale

AS BUILT SKETCH

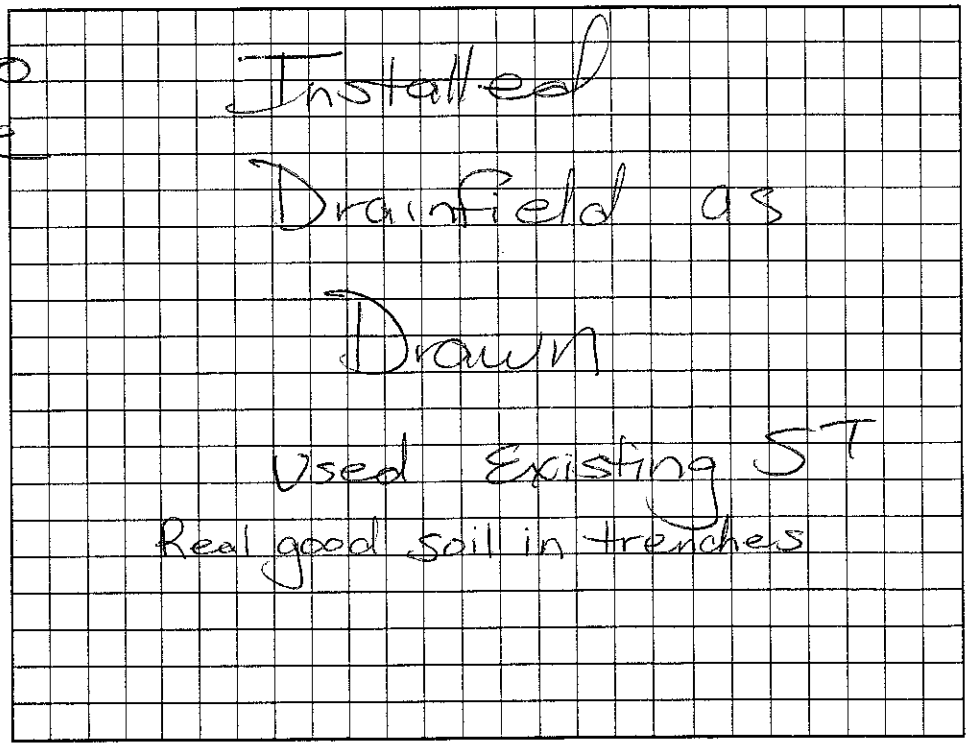

Permit can be suspended or revoked if any false information is supplied toward securing the permit/any unauthorized changes are made to the site/any unauthorized changes are made in the installation of the system. Improvement Permit with plat valid without expiration. Improvement Permit with site plan valid for sixty months. Authorization to Construct is valid for a period equal to that of Improvement Permit, not to exceed sixty months.

Signed: Gary L. Overcash Jr. date —

Installed by: Iredell Backhoe

Improvement Permit by: Maria H. Colon RS date 6/5/03

Operation Permit by: Maria H. Colon RS date 6/24/03

Authorization to Construct by: Maria H. Colon RS date 6/5/03

Existing System Inspection by: — date —

HEALTH DEPT. COPY: WHITE OWNER COPY (FINAL): YELLOW OWNER COPY (INITIAL): PINK