IREDELL COUNTY HEALTH DEPARTMENT

STATESVILLE 704-878-5305 — 0 — MOORESVILLE 704-664-5281

IMPROVEMENT PERMIT / AUTHORIZATION TO CONSTRUCT / OPERATION PERMIT / EXISTING SYSTEM INSPECTI

PERMIT# 110570 PIN# 4669200762 DATE 3-25-03

OWNER OR CONTRACTOR Gary Overcash PHONE: Business _____ Home (704) 664-7182

ADDRESS 34 Shinnville Rd Mooresville NC 28115

LOCATION Hwy 21/115 North TR Shinnville Rd 1 mile on left just before Pond view

SUBDIVISION Pfaff Estates BLOCK / SECTION _____ LOT 1 LOT AREA .52 Acres SITE CLASS. PS DESIGN FLOW 360 gpd L.T.A.R. .

Septic Tank: 1000 Gallons; STB 7007 Date 5-2-03
Pump Tank: _____ Gallons; PT _____ Date _____
Pump Make: _____ Model _____ Serial No. _____
Nitrification Field: No Fields 1 Square Feet 360' Linear Feet 100' (use ext. lines + additional)
No Lines 1 Trench Width 36" Max Trench Bottom Depth 36" Gravel Depth N/A

☒ New System ☐ Repair System Type: I, II, III, IV, V, VI
System Description: Gravity-Conventional
Repair System Description: Innovative
Maintenance Agreement Required: ☐ Yes ☐ No


☒ House/Mod. Home No. Bedrooms 3
☐ Mobile Home No. Bathrooms 2
☐ Business No. Employees ____
☐ Other _____
☐ Slab ☒ Crawl Space ☐ Basement w/plumbing ☐ Basement wo/plumbing

Water Supply: ☒ Individual ☐ Public ☐ Community


Comments:/Conditions: Add new Septic tank (ST) & redirect Flow from Old ST. Cut off existing drainlines so they are 10' from PL & add 1-100' line below to make up difference.

Comments:/Conditions: * Note: Can not install this Drainfield until adjacent house is disconnected from it Blue Filter installed

INITIAL SITE SKETCH "Install "drop boxes"

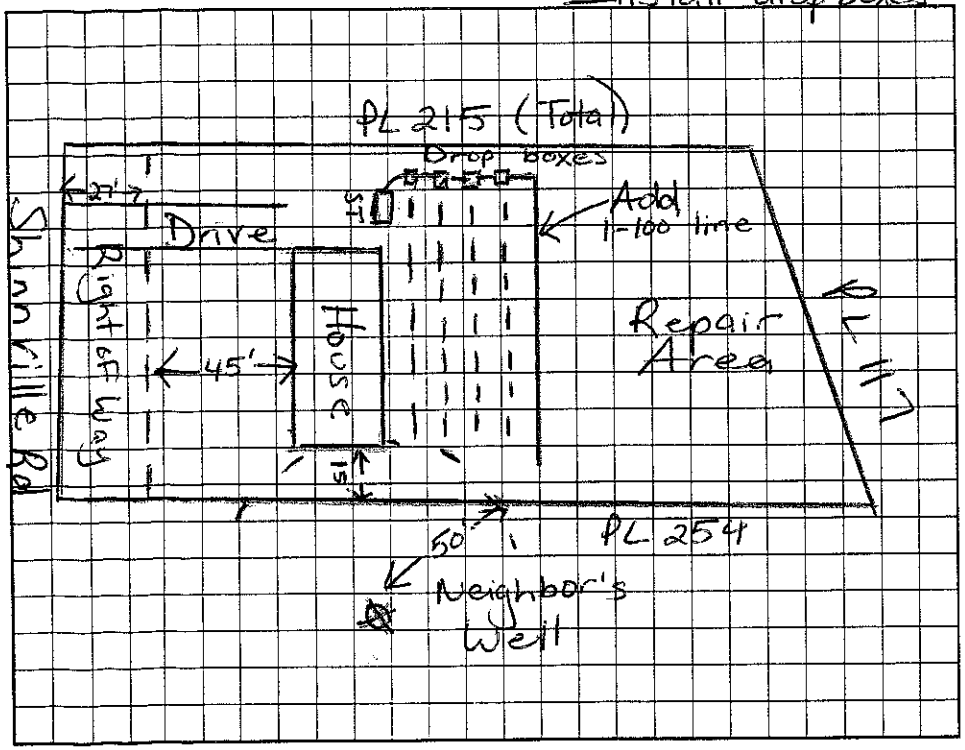

AS BUILT SKETCH

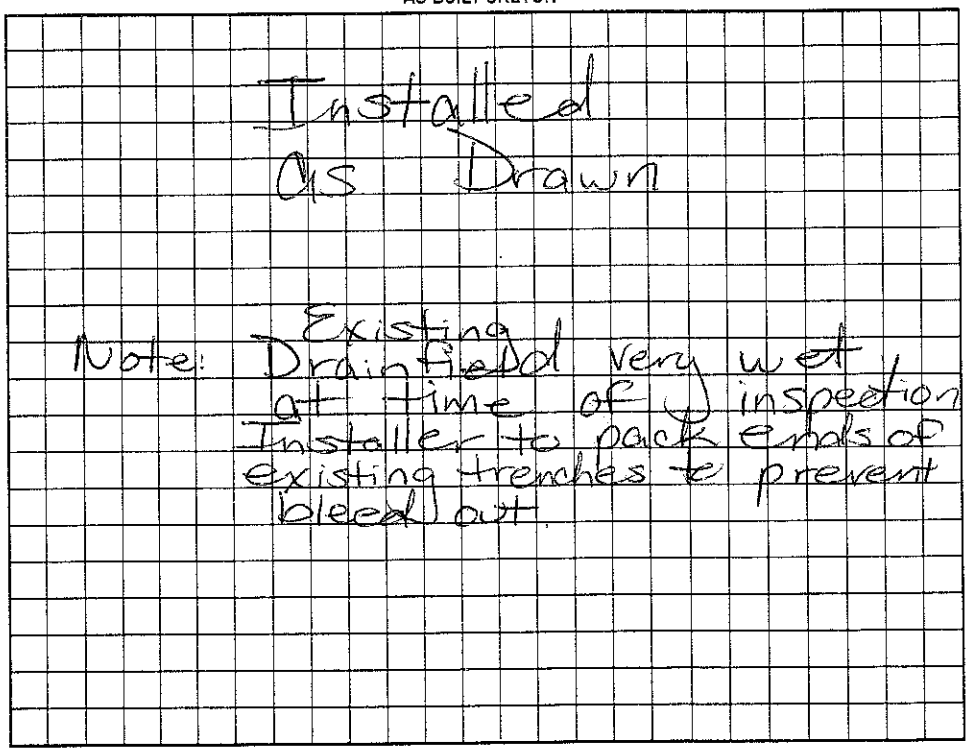

Permit can be suspended or revoked if any false information is supplied toward securing the permit/any unauthorized changes are made to the site/any unauthorized changes are made in the installation of the system. Improvement Permit with plat valid without expiration. Improvement Permit with site plan valid for sixty months. Authorization to Construct is valid for a period equal to that of Improvement Permit – not to exceed sixty months.

Signed: Gary L. Overcash Jr. date 3-25-03 Installed by: Iredell Backhoe & Septic

Improvement Permit by: Maina H. Dotson RS date 3/25/03 Operation Permit by: Maina H. Dotson RS date 6/24/03

Authorization to Construct by: Maina H. Dotson RS date 3/25/03 Existing System Inspection by: _____ date _____

HEALTH DEPT. COPY: WHITE OWNER COPY (FINAL): YELLOW OWNER COPY (INITIAL): PINK