IREDELL COUNTY HEALTH DEPARTMENT

STATESVILLE 704-878-5305 MOORESVILLE 704-664-5281

IMPROVEMENT PERMIT / ~~CERTIFICATE OF COMPLETION~~ / OPERATION PERMIT / EXISTING SYSTEM INSPECTION

AUTHORIZATION TO CONSTRUCT (1100)

PROPERTY DESCRIPTION NO. 070040 DATE 11/26/97 TAX MAP NO. 4669203~~4~~ 547

OWNER OR CONTRACTOR CLIFFORD PHILLERS PHONE: Business _____ Home 528-3320 Watershed: ☐ Yes

ADDRESS 366 SHINVILLE RD.

LOCATION SHINVILLE RD - CORNER OF POND VIEW DR

SUBDIVISION _____ BLOCK / SECTION _____ LOT _____ LOT AREA 2.24AC SITE CLASS. PS DESIGN FLOW 360 L.T.A.R. .3

Septic Tank: 1000 Gallons; STB 1812 Date 9/17/97

Pump Tank: _____ Gallons; PT _____ Date _____

Pump Make: _____ Model _____ Serial No. _____

Nitrification Field: No Fields 1 Square Feet 1200 Linear Feet 400

No Lines 4@100' Trench Width 36" Max Trench Bottom Depth 36" Gravel Depth 12"

☑ New System ☐ Repair System Type: I, II, III, IV, V, VI

System Description: GRAVITY CONVENTIONAL

Repair System Description: SAME

Maintenance Agreement Required: ☐ Yes ☑ No

☑ House/Mod. Home No. Bedrooms 3

☐ Mobile Home No. Bathrooms 3

☐ Business No. Employees ____

☐ Other _____


☐ Slab ☑ Crawl Space ☐ Basement w/plumbing ☐ Basement wo/plumbing

Water Supply: ☑ Individual ☐ Community ☐ Public


Comments:

Comments: WELL NOT INSTALLED AT TIME OF INSPECTION

INITIAL SITE SKETCH 1"=60'

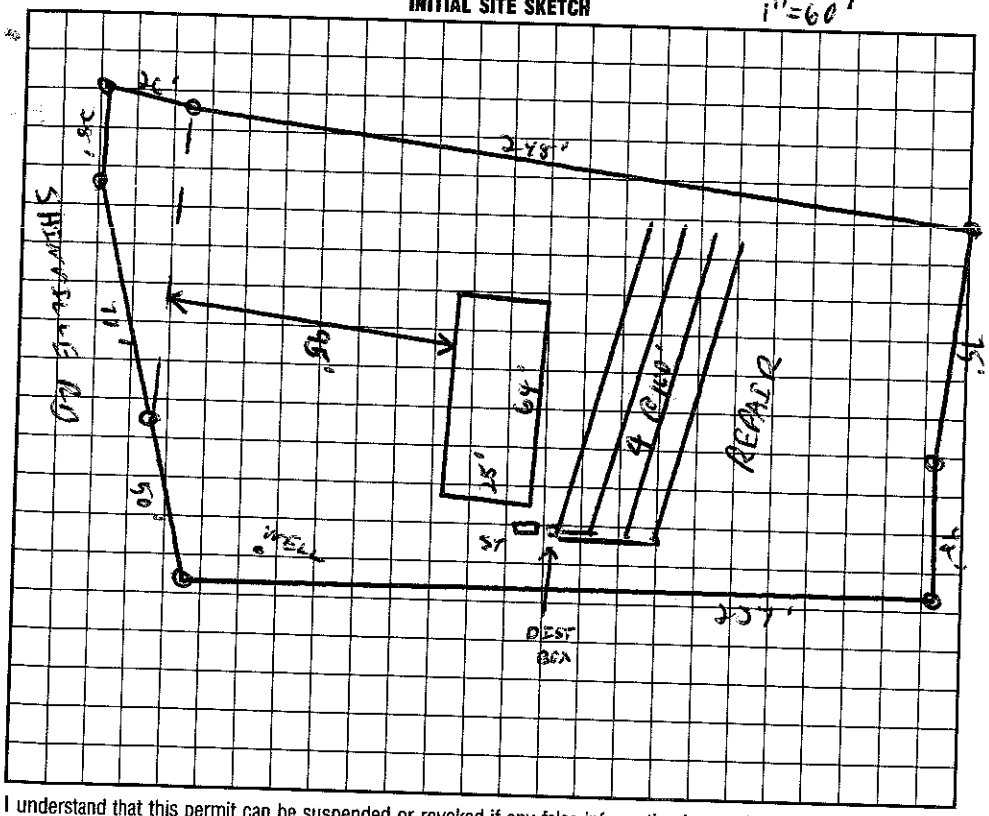

AS BUILT SKETCH

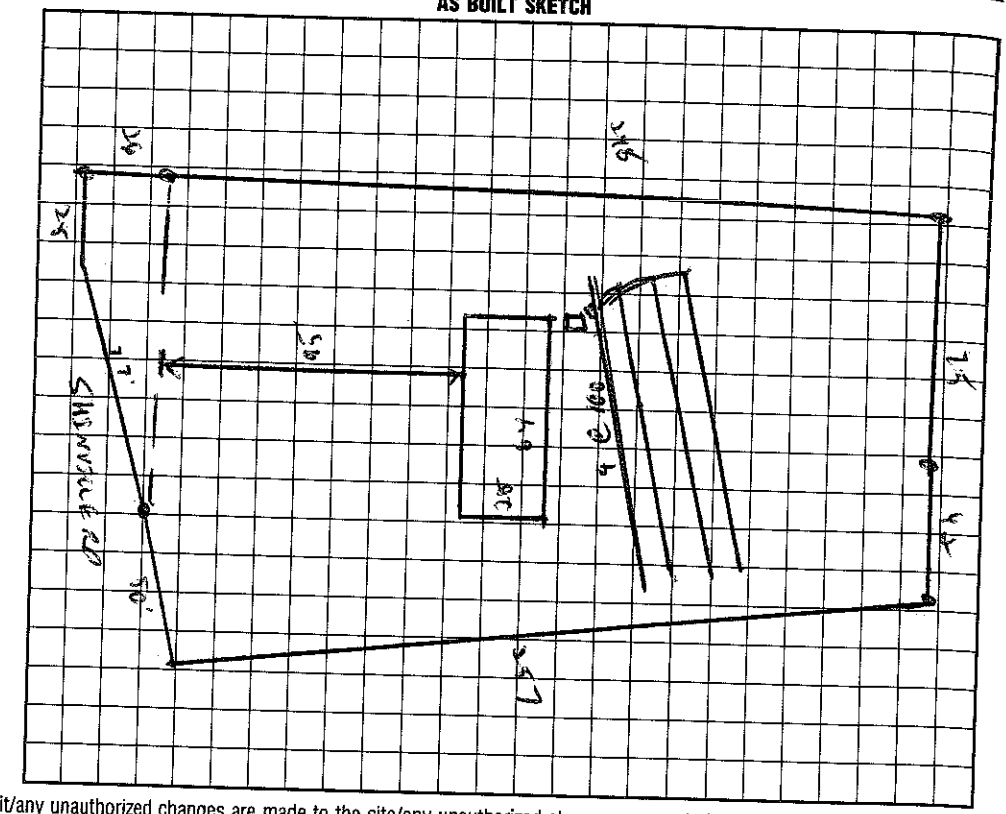

I understand that this permit can be suspended or revoked if any false information is supplied toward securing the permit/any unauthorized changes are made to the site/any unauthorized changes are made in the installation of the system. Improvement Permit is valid for 60 months from date of issuance.

Signed: Russell Phillers

Improvement Permit by: C. Ray Freeman RS date 11/26/97

AUTHORIZATION TO CONSTRUCT

~~Existing System Inspection by:~~ C. Ray Freeman RS date 11/26/97

Installed by: A1 BACKHOE

Certificate of Completion by: _____ date _____

Operation Permit by: C. Ray Freeman date 12/4/97

HEALTH DEPT. COPY: WHITE INSPECTION COPY (FINAL): GREEN OWNER COPY (FINAL): YELLOW INSPECTION COPY (INITIAL): PINK OWNER COPY (INITIAL): GOLD