IREDELL COUNTY HEALTH DEPARTMENT

AUTHORIZATION TO CONSTRUCT 4669203777

STATESVILLE 704-878-5305 MOORESVILLE 704-664-5281

IMPROVEMENT PERMIT / ~~CERTIFICATE OF COMPLETION~~ / OPERATION PERMIT / EXISTING SYSTEM INSPECTION

PROPERTY DESCRIPTION NO. 24934 DATE 8/23/96 TAX MAP NO. 1Q-Z-A-19 Watershed: ☐ Yes ☑ ~~No~~

OWNER OR CONTRACTOR MICHAEL HOKE PHONE: Business _____ Home _____

ADDRESS JIM WALTERS BUILDERS - PO BOX 668046 - CHARLOTTE NC 28266

LOCATION HWY 115 N - TR SHINGLE RD - 1 MILE ON RT PAST PINO VIEW LN

SUBDIVISION _____ BLOCK / SECTION _____ LOT 19 LOT AREA ≈ 5 AC SITE CLASS. PS DESIGN FLOW 360 L.T.A.R. ~~.4~~ Existing

Septic Tank: _____ Gallons; STB _____ Date _____

Pump Tank: _____ Gallons; PT _____ Date _____

Pump Make: _____ Model _____ Serial No. _____

Nitrification Field: No Fields _____ Square Feet _____ Linear Feet _____

No Lines _____ Trench Width _____ Max Trench Bottom Depth _____ Gravel Depth _____

☑ New System ☐ Repair System Type: I, (II), III, IV, V, VI

System Description: GRAVITY CONVENTIONAL

Repair System Description: Same

Maintenance Agreement Required: ☐ Yes ☑ No

☑ House/Mod. Home No. Bedrooms 3

☐ Mobile Home No. Bathrooms 2

☐ Business No. Employees _____

☐ Other _____


☐ Slab ☑ Crawl Space ☐ Basement w/plumbing ☐ Basement wo/plumbing

Water Supply: ☑ ~~Individual~~ ☐ Community ☐ Public

Comments: KEEP 3BR DWELLING 5' FROM SYSTEM. (CHANGING FROM 3BR MH TO 3BR HOUSE.) EXISTING

Comments:

INITIAL SITE SKETCH

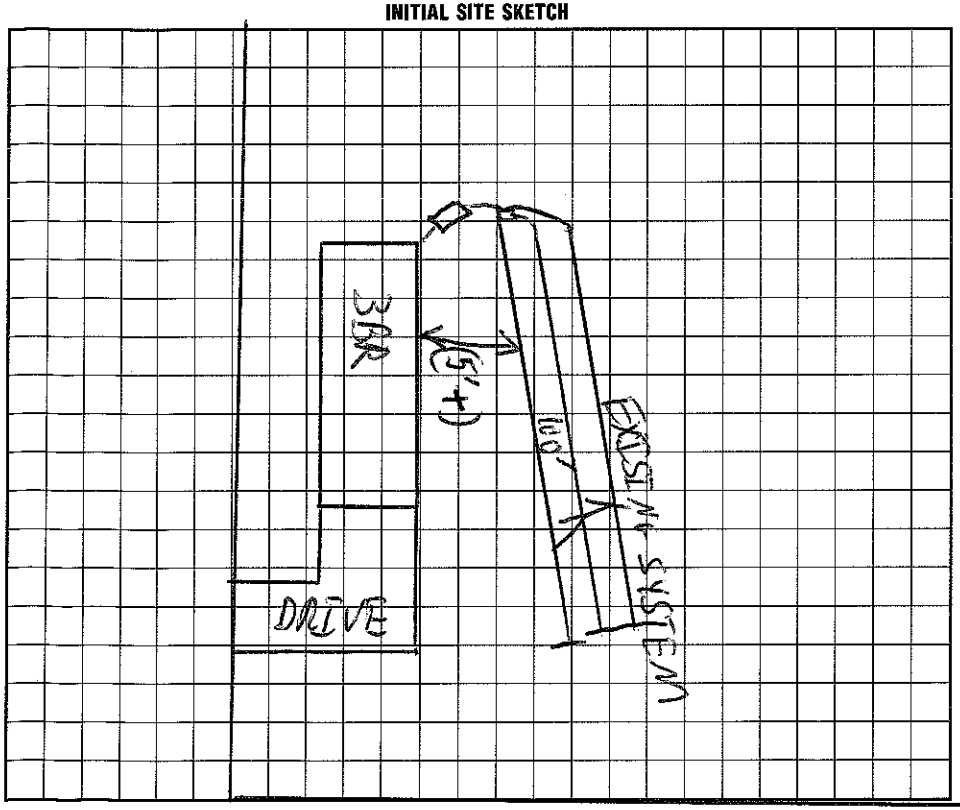

AS BUILT SKETCH

I understand that this permit can be suspended or revoked if any false information is supplied toward securing the permit/any unauthorized changes are made to the site/any unauthorized changes are made in the installation of the system.

Signed: Jim Walters Homes, Inc. By: _____

Installed by: _____

Improvement Permit by: _____ date _____

Certificate of Completion by: _____ date _____

Existing System Inspection by: C. Bly Jr EHS date 8/23/96

Operation Permit by: C. Bly Jr EHS date 8/23/96

HEALTH DEPT. COPY: WHITE INSPECTION COPY (FINAL): GREEN OWNER COPY (FINAL): YELLOW INSPECTION COPY (INITIAL): PINK OWNER COPY (INITIAL): GOLD