IREDELL COUNTY HEALTH DEPARTMENT

AUTHORIZATION TO CONSTRUCT

4669205252

STATESVILLE 704-878-5305 MOORESVILLE 704-664-5281

IMPROVEMENT PERMIT / ~~CERTIFICATE OF COMPLETION~~ / OPERATION PERMIT / EXISTING SYSTEM INSPECTION

PROPERTY DESCRIPTION NO. 25668 DATE 1/7/97 TAX MAP NO. ~~6-A-7~~ 10-A-7 Watershed: ☐ Yes ☑ No

OWNER OR CONTRACTOR TERRY THORNSBERRY PHONE: Business _____ Home 662-8064

ADDRESS 151 REBEL HILL MOORESVILLE

LOCATION 115 N. TR SHINVILLE - TR PONDVIEW - TR REBEL HILL - ON LEFT

SUBDIVISION _____ BLOCK / SECTION _____ LOT _____ LOT AREA 1.2 AC SITE CLASS. PS DESIGN FLOW 360 GPD L.T.A.R. _____

Septic Tank: EXISTING Gallons; STB _____ Date _____

Pump Tank: _____ Gallons; PT _____ Date _____

Pump Make: _____ Model _____ Serial No. _____

Nitrification Field: No Fields 1 Square Feet 300 Linear Feet 100

No Lines 2 Trench Width 36" Max Trench Bottom Depth 36" Gravel Depth 12"

☑ New System ☐ Repair System Type: I, II, III, IV, V, VI

System Description: GRAVITY CONVENTIONAL

Repair System Description: SAME

Maintenance Agreement Required: ☐ Yes ☑ No

☐ House/Mod. Home No. Bedrooms 3

☑ Mobile Home No. Bathrooms 2

☐ Business No. Employees _____

☐ Other _____


☐ Slab ☑ Crawl Space ☐ Basement w/plumbing ☐ Basement wo/plumbing

Water Supply: ☑ Individual ☐ Community ☐ Public

Comments: ADDITION OF 2 LINES AT 50' BEFORE TRAILOR IS TO BE OCCUPIED.

Comments:

INITIAL SITE SKETCH

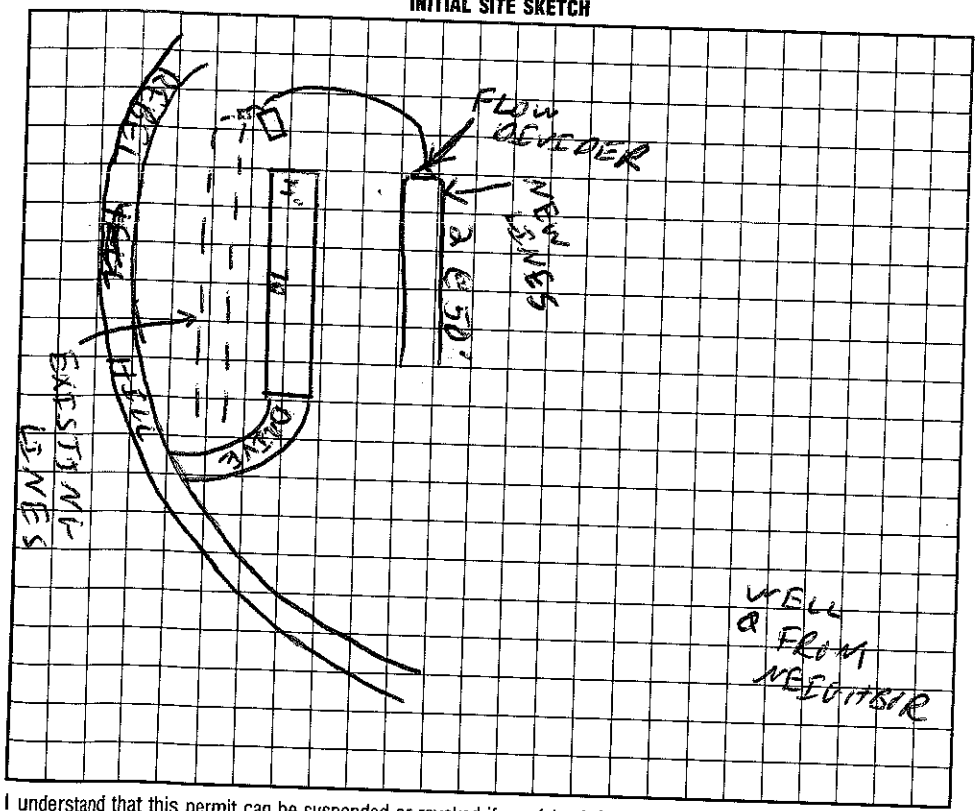

AS BUILT SKETCH

I understand that this permit can be suspended or revoked if any false information is supplied toward securing the permit/any unauthorized changes are made to the site/any unauthorized changes are made in the installation of the system. Improvement Permit is valid for 60 months from date of issuance.

Signed: Albert Thornsberry for Terry Thornsberry

Improvement Permit by: C. Bby Zan EHSE date 1/7/97

Existing System Inspection by: C. Bby Zan EHSE date 1/7/97

Installed by: F J Ervin

Certificate of Completion by: _____ date _____

Operation Permit by: Wesley Sparkman date 1/15/97

HEALTH DEPT. COPY: WHITE INSPECTION COPY (FINAL): GREEN OWNER COPY (FINAL): YELLOW INSPECTION COPY (INITIAL): PINK OWNER COPY (INITIAL): GOLD