IREDELL COUNTY HEALTH DEPARTMENT

Statesville Office (704) 878-5305 Mooresville Office (704) 660-3625 PERMIT # 211320

IMPROVEMENT PERMIT / AUTHORIZATION TO CONSTRUCT / OPERATION PERMIT (EXISTING SYSTEM)

PIN # 4669 20 8074

APPLICANT: Ben & Debra Fuller APPLICANT ADDRESS: 151 Rebel Hill Lane Mooresville, NC. 28115

SITE ADDRESS: 151 Rebel Hill Lane PHONE: 704-662-8064 ALT. PHONE:

SITE DIRECTIONS: 115-21 N TR Shimmel Rd. TR Pond View TR Rebel Hill to 151 on (L)


SUBDIVISION: Ben & Debra Fuller SECTION: LOT # 3 LOT AREA: 5.51 DESIGN FLOW: 480 L.T.A.R.:

Septic Tank	EXISTING (gal)	STB		Date		☐ New System ☐ Repair ☐ Expansion	System Type: I (II) III IV V VI	☑ Residence	No. Bedrooms 4
Pump Tank	(gal)	PT		Date		System Description: EXISTING CONVENTIONAL		☐ Business	No. Persons
Pump Make	Model			Serial #		Repair System Description:		☐ Other	No. Employees
# Nitrification Fields 1	# Lines 5			Linear Ft: 500		Maintenance Agreement Required: ☐ YES ☑ NO		☐ Slab	☑ Crawl Space
Trench Width	Max. Trench Bottom Depth			Gravel Depth		☑ GRAVITY ☐ PRESSURE		☐ Basement w/plumbing	☐ Basement w/o plumbing


Water Supply: ☑ Private ☐ Public ☐ Community

Comments / Conditions: EXISTING SYSTEM IS NOT IMPACTED BY THE DECK ADDITION.

INITIAL SITE SKETCH

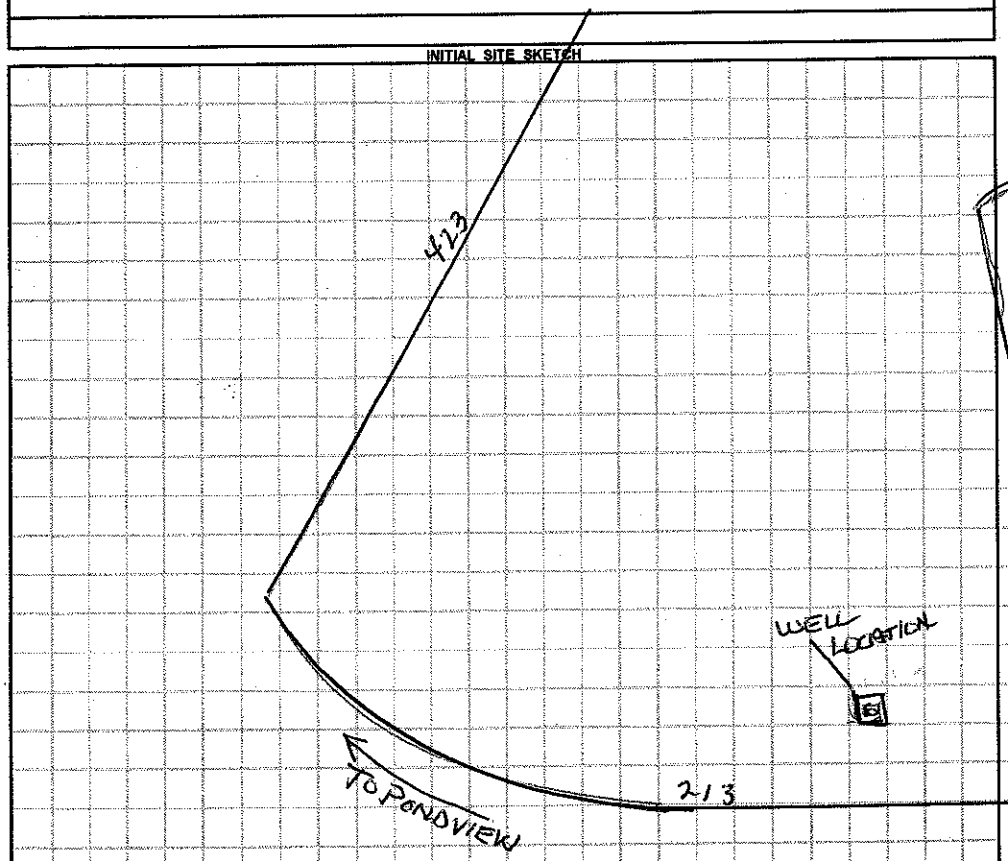

AS BUILT SKETCH

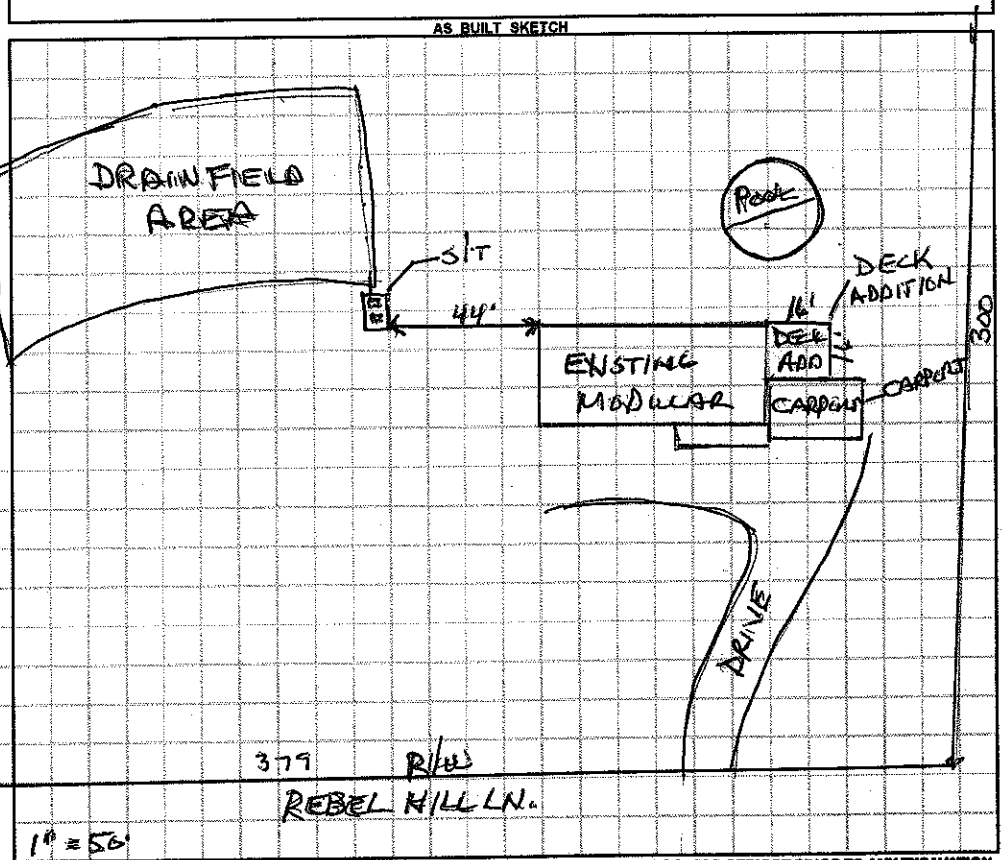

Permit can be suspended or revoked if any false information is supplied toward securing the permit / any unauthorized changes are made to the site / any unauthorized changes are made in the installation of the system. **CONTACT A LOCATOR SERVICE PRIOR TO ANY EXCAVATION**

☐ **IMPROVEMENT PERMIT** *with plat valid without expiration.* ☐ **IMPROVEMENT PERMIT** *with site plan valid for 60 mos.* ☐ **AUTHORIZATION TO CONSTRUCT** *valid for period equal to IMPROVEMENT PERMIT--not to exceed 60 mo.*

Owner / Applicant Signature: [signature] Date: 6.25.15 Installed by:

IMPROVEMENT PERMIT by: Date: OPERATION PERMIT by: Date:

AUTHORIZATION TO CONSTRUCT by: Date: Existing System Inspected by: Wesley Sparks REHS Date: 6/24/2015

Health Dept. Copy - WHITE Applicant (Final Approval) - YELLOW Applicant (Conditional Approval) - PINK