IREDELL COUNTY HEALTH DEPARTMENT

STATESVILLE 704-878-5305 MOORESVILLE 704-664-5281

IMPROVEMENT PERMIT / AUTHORIZATION TO CONSTRUCT / OPERATION PERMIT / EXISTING SYSTEM INSPECTION

PERMIT# 102722 PIN# 4669-20-8231 4669209308 DATE 3/4/02

OWNER OR CONTRACTOR Benny + Debra Fuller/John Tumazzy PHONE: Business 704-662-8064 Home

ADDRESS 151 Rebel Hill Mooresville NC 28115

LOCATION 21 N, TR Shinnville, TR Pondview on Corner of Rebel Hill

SUBDIVISION BLOCK / SECTION LOT LOT AREA 5.164C SITE CLASS. PS DESIGN FLOW 360 L.T.A.R. 0.5

Septic Tank: 1000 Gallons; STB 1012 Date 2/23/06
Pump Tank: Gallons; PT Date
Pump Make: Model Serial No.
Nitrification Field: No Fields 1 Square Feet 900 Linear Feet 360
No Lines 4 Trench Width 36" Max Trench Bottom Depth 36" Gravel Depth —

☒ New System ☐ Repair System Type: I. II. III. IV. V. VI
System Description: Gravity 25% Red.
Repair System Description: LPP Panel
Maintenance Agreement Required: ☐ Yes ☒ No

☒ House/Mod. Home No. Bedrooms 3
☐ Mobile Home No. Bathrooms 2
☐ Business No. Employees
☐ Other


☐ Slab ☒ Crawl Space ☐ Basement w/plumbing ☐ Basement wo/plumbing

Water Supply: ☒ Individual ☐ Public ☐ Community


Comments/Conditions: Keep Well 100' from Any septic System complex

Comments/Conditions:

INITIAL SITE SKETCH

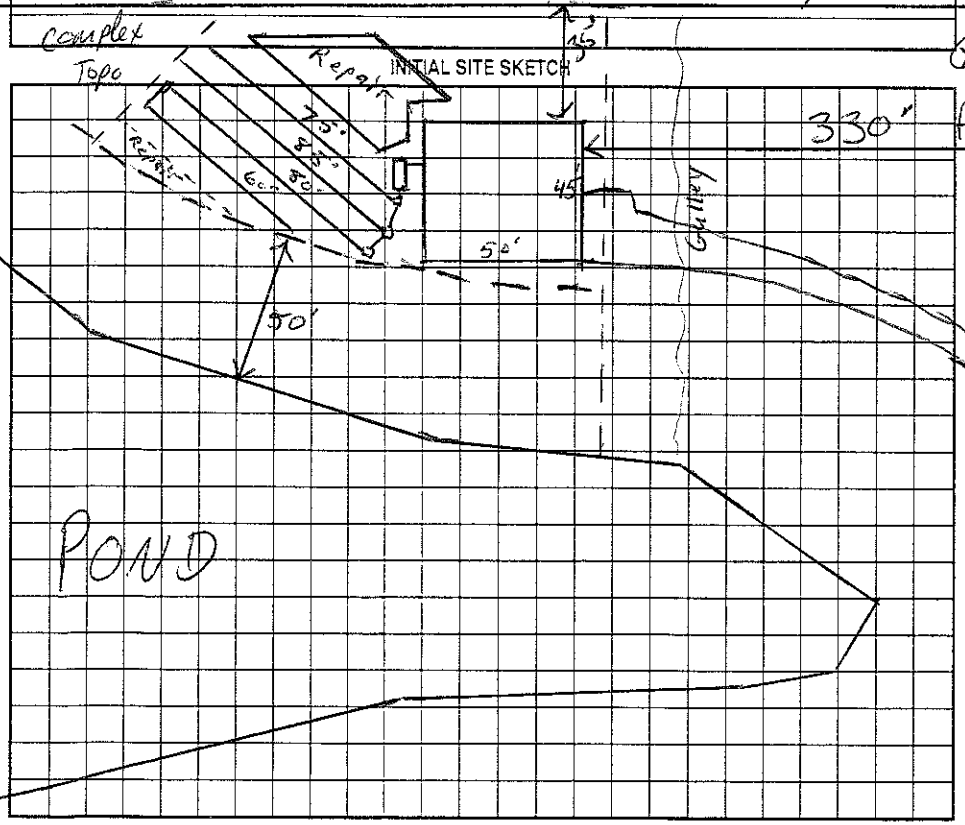

AS BUILT SKETCH

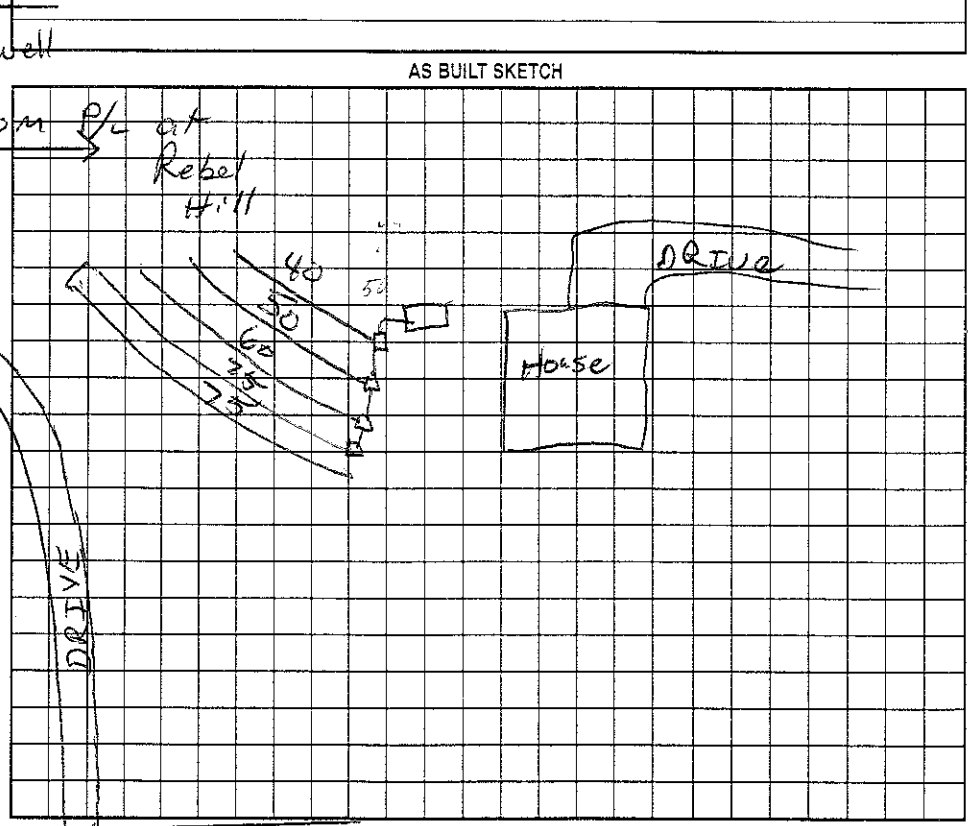

Permit can be suspended or revoked if any false information is supplied toward securing the permit/any unauthorized changes are made to the site/any unauthorized changes are made in the installation of the system. Improvement Permit with plat valid without expiration. Improvement Permit with site plan valid for sixty months. Authorization to Construct is valid for a period equal to that of Improvement Permit – not to exceed sixty months.

Signed: Debra K. Fuller date Installed by: Tommy Frye

Improvement Permit by: RS date 3/4/02 Operation Permit by: RS date 8/25/06

Authorization to Construct by: RS date 9/22/05 Existing System Inspection by: date

HEALTH DEPT. COPY: WHITE OWNER COPY (FINAL): YELLOW OWNER COPY (INITIAL): PINK