IREDELL COUNTY HEALTH DEPARTMENT

STATESVILLE 704-878-5305 MOORESVILLE 704-664-5281

IMPROVEMENT PERMIT / AUTHORIZATION TO CONSTRUCT / OPERATION PERMIT / EXISTING SYSTEM INSPECTION

PERMIT# Repair PIN# NA 4669217604 DATE 8/26/05

OWNER OR CONTRACTOR Carl Asselone PHONE: Business Home 704-658-1700

ADDRESS 418 Shinnville Rd. Mooresville, NC. 28115

LOCATION 115 TR Shinnville Rd. ~ 1.5 miles on (R) # 418

SUBDIVISION No BLOCK / SECTION LOT LOT AREA EXISTING SITE CLASS. PS DESIGN FLOW 240 L.T.A.R. .3

Septic Tank: EXISTING Gallons; STB Date

Pump Tank: Gallons; PT 1 Date

Pump Make: Model Serial No. 200

Nitrification Field: No Fields 1 Square Feet 900 Linear Feet ~~300~~

No Lines 3 @ 100' Trench Width 3' Max Trench Bottom Depth 3'

☐ New System ☒ Repair System Type: I, II, (III), IV, V, VI

System Description:

Repair System Description: GRAVITY -25% Reduced

Maintenance Agreement Required: ☐ Yes ☐ No

☒ House/Mod. Home No. Bedrooms 2

☐ Mobile Home No. Bathrooms 1

☐ Business No. Employees

☐ Other


Gravel Depth No ☐ Slab ☒ Crawl Space ☐ Basement w/plumbing ☐ Basement wo/plumbing

Water Supply: ☒ Individual ☐ Public ☐ Community EXISTING

Comments:/Conditions:

Comments:/Conditions:

INITIAL SITE SKETCH

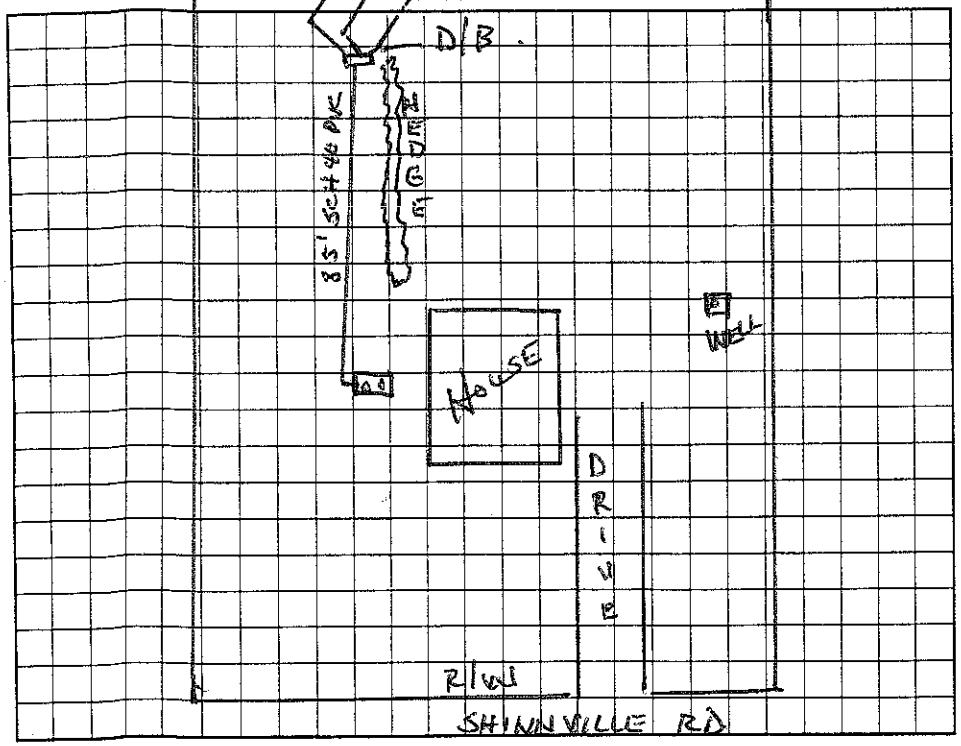

AS BUILT SKETCH

Permit can be suspended or revoked if any false information is supplied toward securing the permit/any unauthorized changes are made to the site/any unauthorized changes are made in the installation of the system. Improvement Permit with plat valid without expiration. Improvement Permit with site plan valid for sixty months. Authorization to Construct is valid for a period equal to that of Improvement Permit – not to exceed sixty months.

Signed: Carl Asselone date 9-2-05 Installed by: Tim Bumgarner

Improvement Permit by: Wesley Sparks R.S. date 8/26/05 Operation Permit by: Wesley Sparks R.S. date 12/21/05

Authorization to Construct by: Wesley Sparks R.S. date 8/26/05 Existing System Inspection by: date

HEALTH DEPT. COPY: WHITE OWNER COPY (FINAL): YELLOW OWNER COPY (INITIAL): PINK