IREDELL COUNTY HEALTH DEPARTMENT

STATESVILLE 704-878-5305 MOORESVILLE 704-664-5281

IMPROVEMENT PERMIT / AUTHORIZATION TO CONSTRUCT / OPERATION PERMIT / EXISTING SYSTEM INSPECTION

PERMIT# Repair PIN# 4669 21 7901 DATE 10/25/01

OWNER OR CONTRACTOR O. M. Morrow PHONE: Business Home 664-1242

ADDRESS 428 Shinnville Rd Mooresville NC 28115

LOCATION 115N, TR Shinnville on Rt

SUBDIVISION BLOCK / SECTION LOT LOT AREA SITE CLASS. PS DESIGN FLOW 360 L.T.A.R.

Septic Tank: Existing Gallons; STB Date

Pump Tank: Gallons; PT Date

Pump Make: Model Serial No.

Nitrification Field: No Fields 1 Square Feet 600 Linear Feet 50'

No Lines 6 Trench Width 12' Max Trench Bottom Depth 36" Gravel Depth 18"

☐ New System ☒ Repair System Type: I II III IV V VI

System Description: ~~Gravity Gravel Bed~~

Repair System Description: Gravity 25% Reduct.

Maintenance Agreement Required: ☐ Yes ☐ No

☒ House/Mod. Home ☐ Mobile Home ☐ Business ☐ Other

No. Bedrooms 3 No. Bathrooms 2 No. Employees


☐ Slab ☐ Crawl Space ☐ Basement w/plumbing ☒ Basement wo/plumbing

Water Supply: ☒ Individual ☐ Public ☐ Community


Comments:/Conditions:

Comments:/Conditions:

INITIAL SITE SKETCH

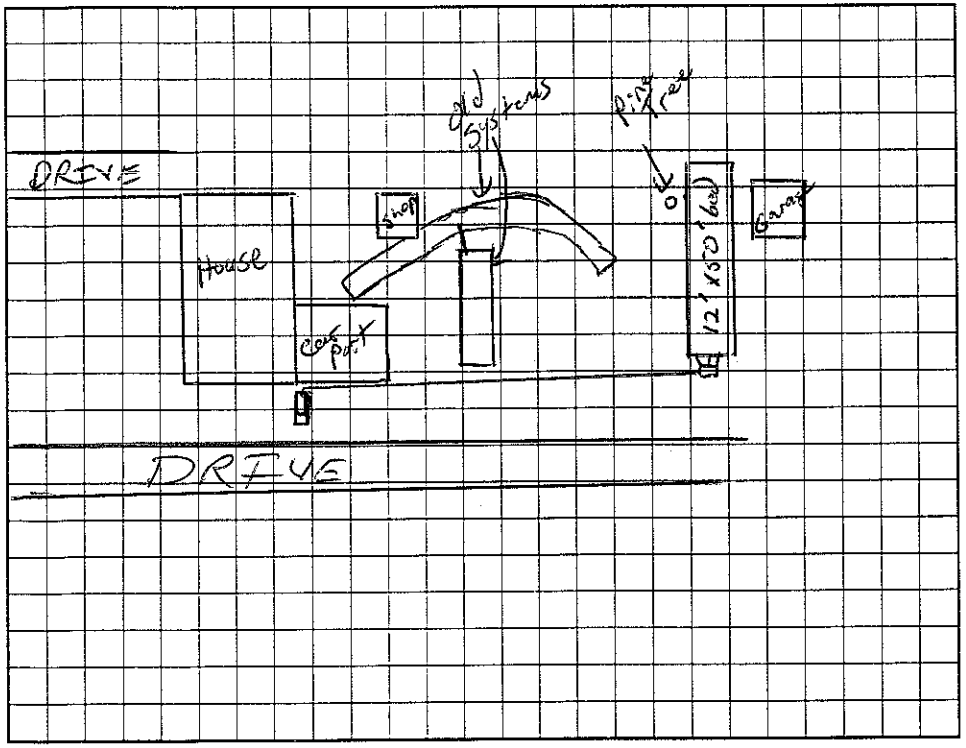

AS BUILT SKETCH

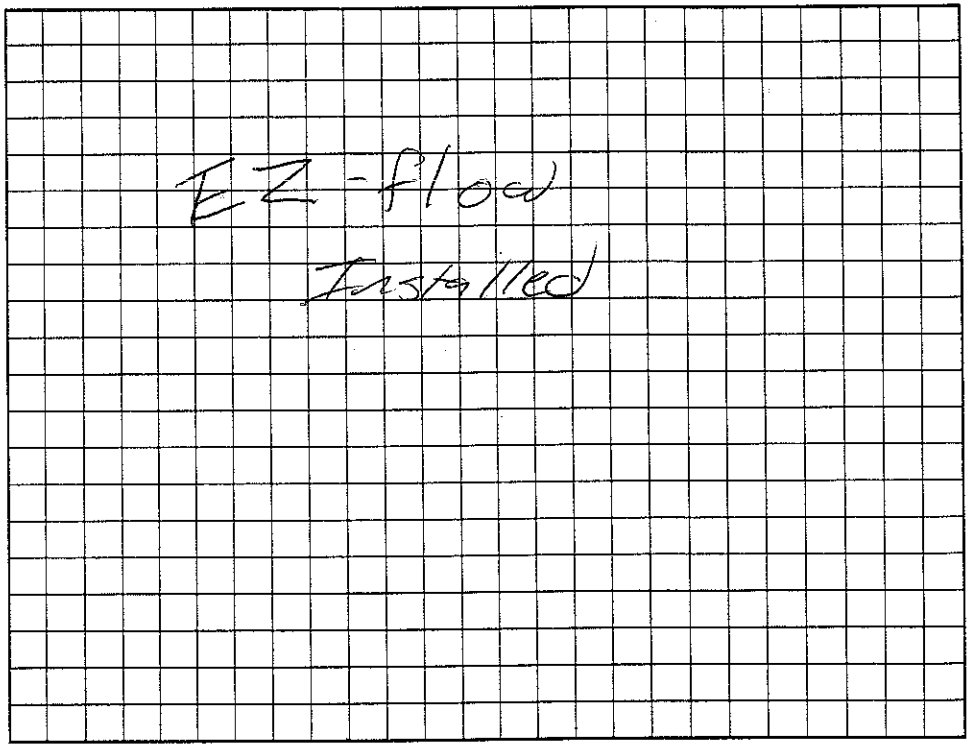

Permit can be suspended or revoked if any false information is supplied toward securing the permit/any unauthorized changes are made to the site/any unauthorized changes are made in the installation of the system. Improvement Permit with plat valid without expiration. Improvement Permit with site plan valid for sixty months. Authorization to Construct is valid for a period equal to that of Improvement Permit – not to exceed sixty months.

Signed: O. M. Morrow date 10-25-01 Installed by: Tim Ammons

Improvement Permit by: RSI date 10/25/01 Operation Permit by: RSI date 10/30/01

Authorization to Construct by: RSI date 10/25/01 Existing System Inspection by: date

HEALTH DEPT. COPY: WHITE OWNER COPY (FINAL): YELLOW OWNER COPY (INITIAL): PINK