IREDELL COUNTY HEALTH DEPARTMENT

STATESVILLE 704-878-5305 MOORESVILLE 704-664-5281

IMPROVEMENT PERMIT / AUTHORIZATION TO CONSTRUCT / OPERATION PERMIT / EXISTING SYSTEM INSPECTION

2.00

PERMIT# 074807 PIN# ~~4669-71-3956~~ 4669222080 DATE 8/20/98

OWNER OR CONTRACTOR Ruby White PHONE: Business 660-1827 Home

ADDRESS PO Box 1494 Mooresville, NC. 28115

LOCATION Dinger Lane, 115 N TR Shumville Rd, on (R) before 2nd house

SUBDIVISION BLOCK / SECTION LOT LOT AREA 1.71 SITE CLASS PS DESIGN FLOW 360 L.T.A.R. .3

Septic Tank: 1000 Gallons; STB 1012 Date 6/22/95
Pump Tank: Gallons; PT Date
Pump Make: Model Serial No.
Nitrification Field: No Fields 1 Square Feet 900* Linear Feet 300*
No Lines 4 Trench Width 36" Max Trench Bottom Depth 30" Gravel Depth SAND

☒ New System ☐ Repair System Type: I, II, (III) IV, V, VI
System Description: GRAV-CH PLASTIC
Repair System Description: SAME
Maintenance Agreement Required: ☐ Yes ☒ No


☐ House/Mod. Home No. Bedrooms 3
☒ Mobile Home No. Bathrooms 2
☐ Business No. Employees
☐ Other
☐ Slab ☒ Crawl Space ☐ Basement w/plumbing ☐ Basement wo/plumbing

Water Supply: ☒ Individual ☐ Public ☐ Community


Comments:/Conditions:

Comments:/Conditions:
WELL NOT LOCATED 8/25/98

INITIAL SITE SKETCH

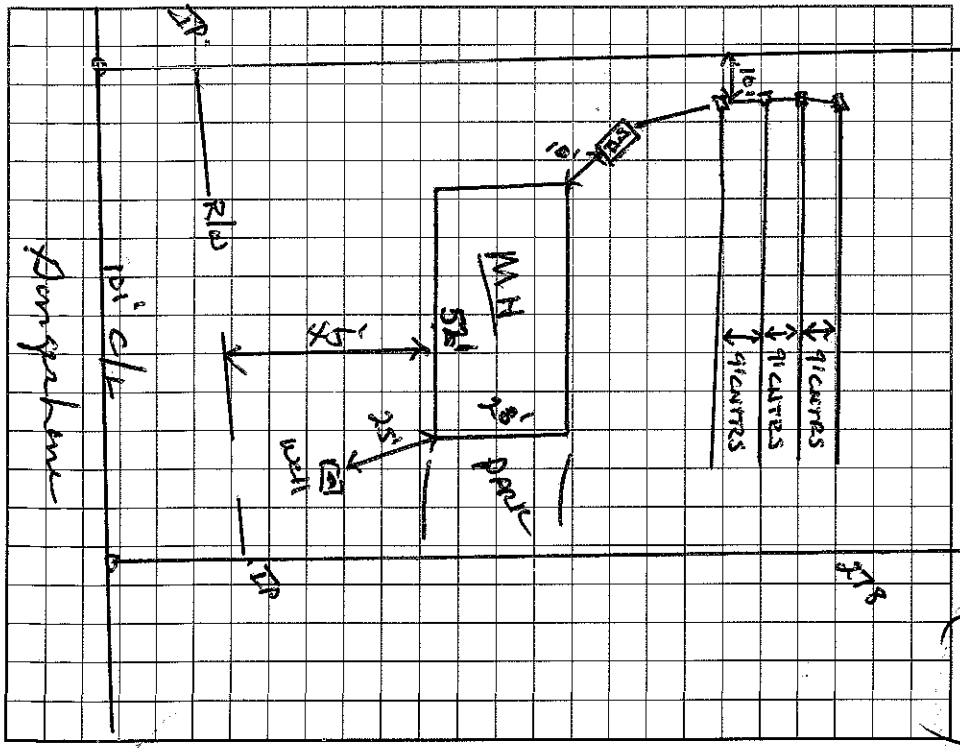

AS BUILT SKETCH

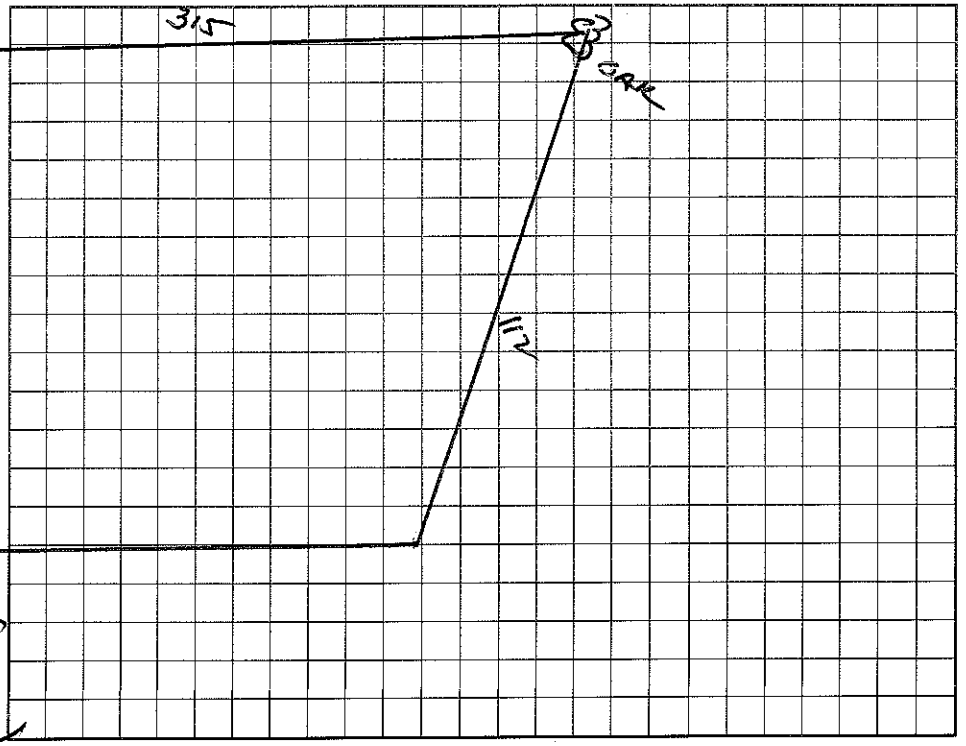

I understand that this permit can be suspended or revoked if any false information is supplied toward securing the permit/any unauthorized changes are made to the site/any unauthorized changes are made in the installation of the system. Improvement Permit with plat valid without expiration. Improvement Permit with site plan valid for sixty months. Authorization to Construct is valid for a period equal to that of Improvement Permit – not to exceed sixty months.

Signed: X Ruby Shelby White date

Improvement Permit by: Wesley Sparks RS. date 8/20/98

Authorization to Construct by: Wesley Sparks RS date 8/20/98

Installed by: 41 BACKHOE

Operation Permit by: C. [signature] date 8/25/98

Existing System Inspection by: date

HEALTH DEPT. COPY: WHITE INSPECTION COPY (FINAL): GREEN OWNER COPY (FINAL): YELLOW INSPECTION COPY (INITIAL): PINK OWNER COPY (INITIAL): GOLD