IREDELL COUNTY HEALTH DEPARTMENT

Statesville Phone TR 3-7271 Mooresville Phone NO 3-1271

PERMIT TO INSTALL SEPTIC TANK

Permit No. 92 Permit Date 5-31-1972

Owner Kayriker Address Mooresville

Installed By Sam Oswalt Address Troutman


Location of Property 1/2 mi out Shinnville Rd from US 21 on left (Trailor)

Tank		Capacity		Length of Lines		Fixtures	
Block	( )	1000	(✓)	225'	(✓)	No. of Baths	(2)
Precast	(✓)	1250	( )	250'	( )	Dishwasher	(no)
		1500	( )	Other		Garbage Grdr.	(no)
		Other				Other	

NOTIFY HEALTH DEPARTMENT AT LEAST EIGHT HOURS BEFORE TANK IS TO BE INSPECTED.

Final Inspection 5-31-1972 Approved (✓) Disapproved ( )

Remarks

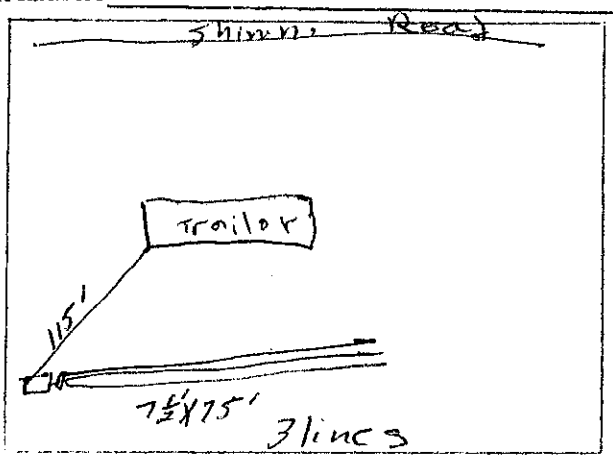

Sketch of Installation

J. C. Moore
Sanitarian