IREDELL COUNTY HEALTH DEPARTMENT

STATESVILLE 704-878-5305 MOORESVILLE 704-664-5281

IMPROVEMENT PERMIT / AUTHORIZATION TO CONSTRUCT / OPERATION PERMIT / EXISTING SYSTEM INSPECTION

PERMIT# 090030 PIN# 4669 27 1592 DATE 7/3/00

OWNER OR CONTRACTOR Richard Vanabel PHONE: Business 664-8993 Home

ADDRESS 405 Big Indian Loop Mooresville, NC. 28117

LOCATION 115 N TR Shinnville Rd. - 2.6 miles on (L)

SUBDIVISION LIBERTY BLOCK / SECTION LOT 2 LOT AREA 3.889 AC SITE CLASS. PS DESIGN FLOW 360 L.T.A.R. .3

Septic Tank: 1000 Gallons; STB 312 Date 7/31/00
Pump Tank: Gallons; PT Date
Pump Make: Model Serial No.
Nitrification Field: No Fields 1 Square Feet 1200 Linear Feet 400
No Lines 4 Trench Width 36" Max Trench Bottom Depth 36" Gravel Depth 12"

[X] New System [ ] Repair System Type: I (II) III, IV, V, VI
System Description: GRAVITY - CONVENTIONAL
Repair System Description: SAME
Maintenance Agreement Required: [ ] Yes [X] No


[X] House/Mod. Home No. Bedrooms 3
[ ] Mobile Home No. Bathrooms 3
[ ] Business No. Employees
[ ] Other
[ ] Slab [X] Crawl Space [ ] Basement w/plumbing [ ] Basement wo/plumbing

Water Supply: [X] Individual [ ] Public [ ] Community


Comments:/Conditions:

Comments:/Conditions:

INITIAL SITE SKETCH (1" = 50')

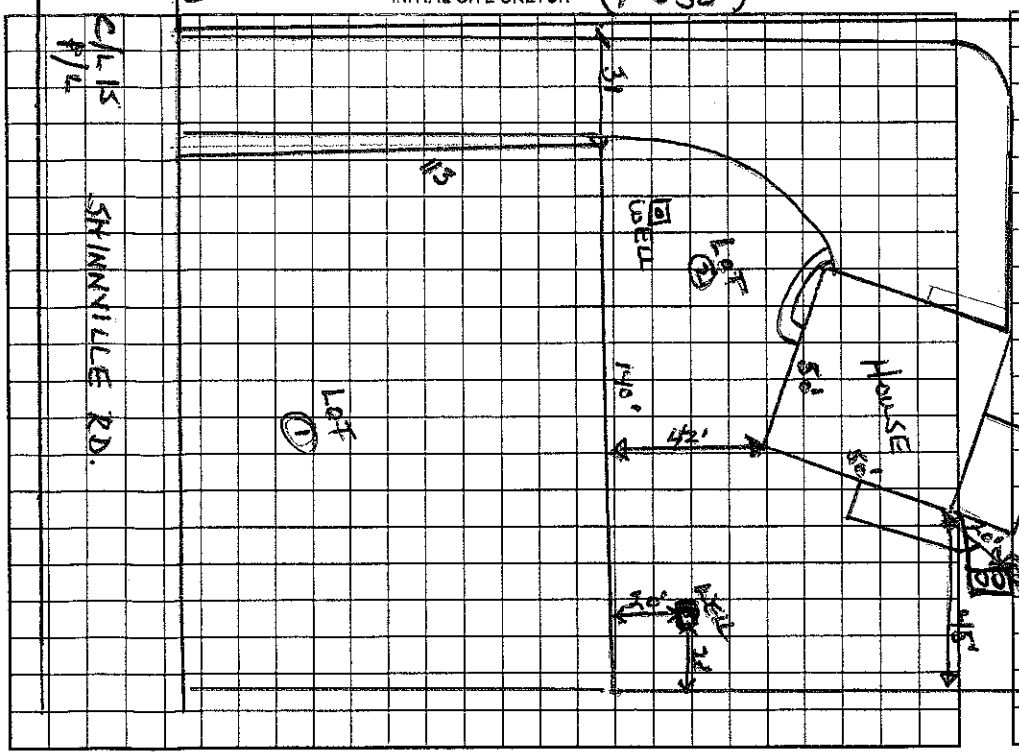

AS BUILT SKETCH

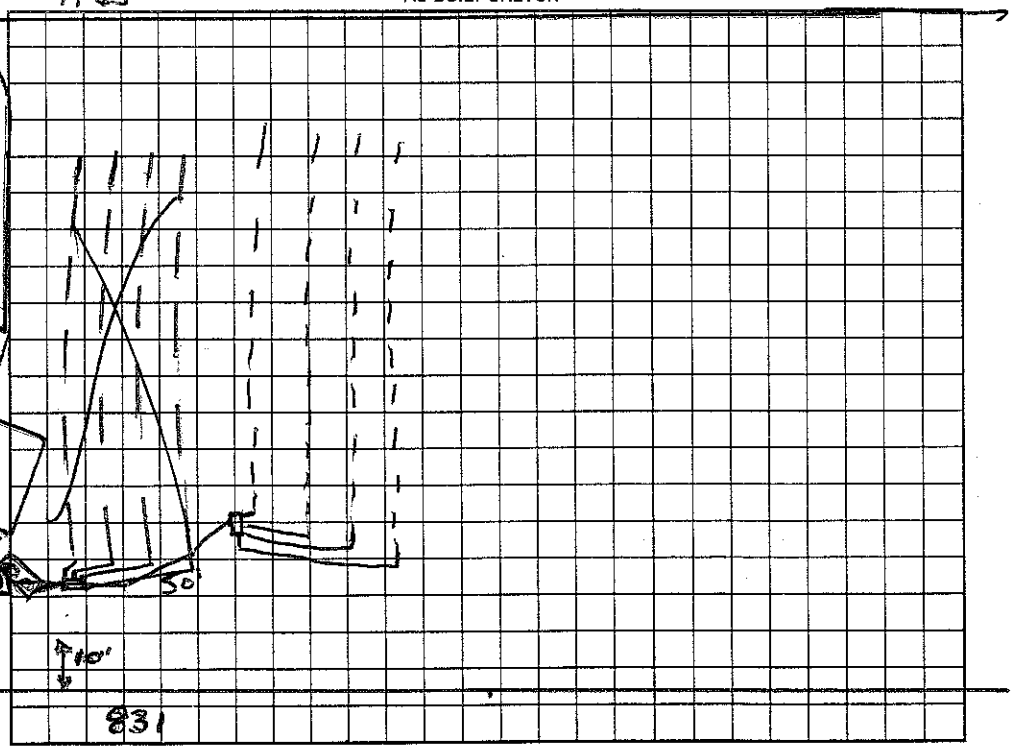

Permit can be suspended or revoked if any false information is supplied toward securing the permit/any unauthorized changes are made to the site/any unauthorized changes are made in the installation of the system. Improvement Permit with plat valid without expiration. Improvement Permit with site plan valid for sixty months. Authorization to Construct is valid for a period equal to that of Improvement Permit – not to exceed sixty months.

Signed: [signature] date 7-6-00 Installed by: Wayne Orbison

Improvement Permit by: Wesley Sparks RS. date 7/3/00 Operation Permit by: Wesley Sparks RS. date 9/12/00

Authorization to Construct by: Wesley Sparks RS. date 7/3/00 Existing System Inspection by: date

HEALTH DEPT. COPY: WHITE OWNER COPY (FINAL): YELLOW OWNER COPY (INITIAL): PINK