# IREDELL COUNTY HEALTH DEPARTMENT

Statesville Office (704) 878-5305 Mooresville Office (704) 660-3625 PERMIT # 178265

## IMPROVEMENT PERMIT / AUTHORIZATION TO CONSTRUCT / OPERATION PERMIT / EXISTING SYSTEM

PIN # 4669 27 4483

APPLICANT: Kelli Midgett APPLICANT ADDRESS: 697 Shinnville Road Mooresville

SITE ADDRESS: 701 + 703 Shinnville Road PHONE: 704 213 0596 ALT. PHONE:

SITE DIRECTIONS: 115 N TR Shinnville Rd. 2.6 miles on left


SUBDIVISION: Liberty SECTION: LOT # 1 LOT AREA: ~ 1 AC DESIGN FLOW: 360 L.T.A.R.: .3

| | | | | | | | | | | | |
|---|---|---|---|---|---|---|---|---|---|---|---|
| Septic Tank | 1000 | (gal) | STB 825 | Date | 12-16-13 | ☒ New System | ☐ Repair | ☐ Expansion | System Type: I II III IV V VI | ☒ Residence | No. Bedrooms 3 |
| Pump Tank | | (gal) | PT | Date | | System Description: | gravity 25% Reduction | | | ☐ Business | No. Persons |
| Pump Make | | Model | | Serial # | | Repair System Description: | LPP/BPS - Lot 1 Extension | | | ☐ Other | No. Employees |
| # Nitrification Fields | 1 | # Lines | @ 4-5 | Linear Ft: | 300 | Maintenance Agreement Required: | ☐ YES | ☒ NO | | ☒ Slab | ☐ Crawl Space |
| Trench Width | 36" | Max. Trench Bottom Depth | 28" | Gravel Depth | NA | | ☒ GRAVITY | ☐ PRESSURE | | ☐ Basement w/plumbing | ☐ Basement w/o plumbing |


Water Supply: ☒ Private Existing ☐ Public ☐ Community

Comments / Conditions: House (Existing) Septic tank must be Relocated to be 100' minimum from Existing Well since this well will Now be used as Multi-family. *Operation Permit for Duplex to Not be signed until this is completed.

INITIAL SITE SKETCH

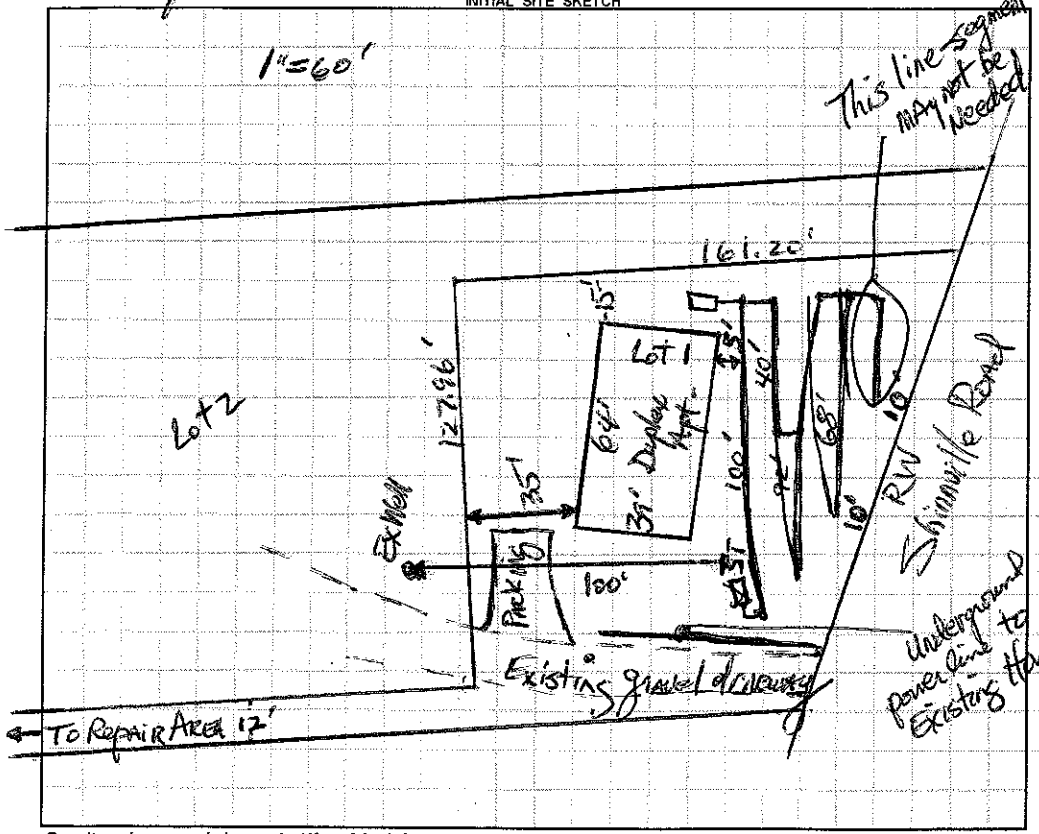


AS BUILT SKETCH

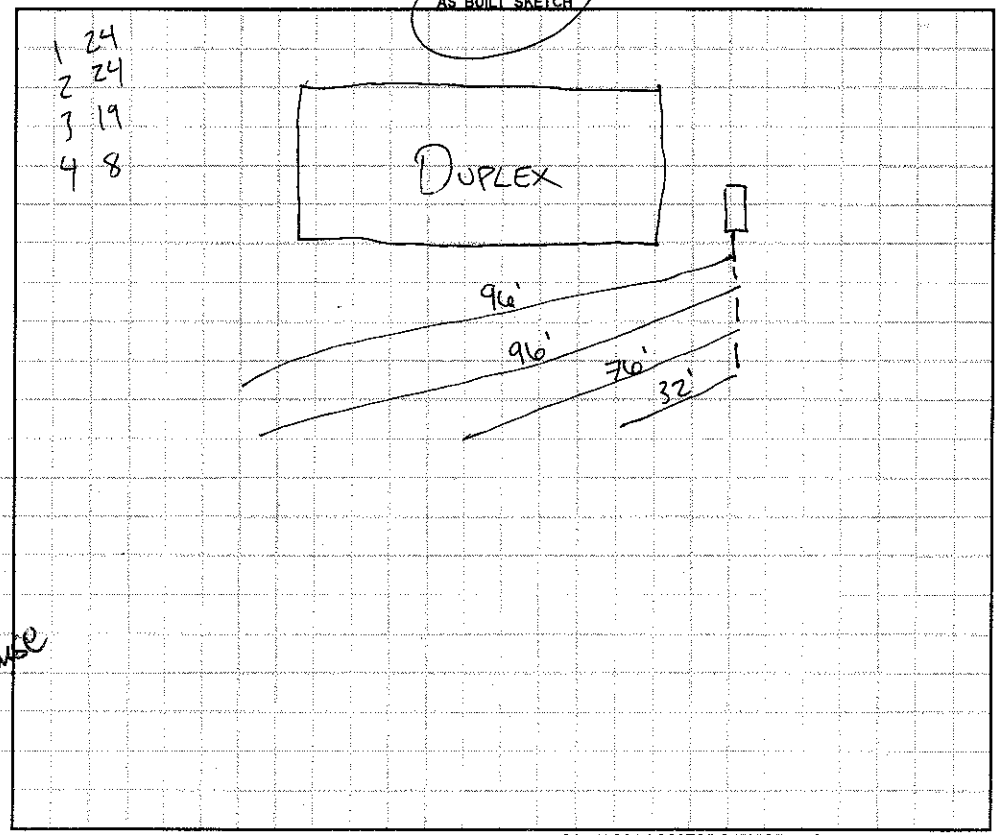


*Permit can be suspended or revoked if any false information is supplied toward securing the permit / any unauthorized changes are made to the site / any unauthorized changes are made in the installation of the system.* **CONTACT A LOCATOR SERVICE PRIOR TO ANY EXCAVATION**

☐ **IMPROVEMENT PERMIT** *with plat valid without expiration.* ☒ **IMPROVEMENT PERMIT** *with site plan valid for 60 mos.* ☐ **AUTHORIZATION TO CONSTRUCT** *valid for period equal to IMPROVEMENT PERMIT--not to exceed 60 mo.*

Owner / Applicant Signature: Date: Installed by: Rowan Septic

IMPROVEMENT PERMIT by: Date: 8-7-13 OPERATION PERMIT by: Date: 1-27-14

AUTHORIZATION TO CONSTRUCT by: Date: 8-7-13 Existing System Inspected by: Date:

Health Dept. Copy - WHITE Applicant (Final Approval) - YELLOW Applicant (Conditional Approval) - PINK