4669278063

IREDELL COUNTY HEALTH DEPARTMENT

STATESVILLE 704-878-5305 MOORESVILLE 704-664-5281

IMPROVEMENT PERMIT / AUTHORIZATION TO CONSTRUCT / OPERATION PERMIT / EXISTING SYSTEM INSPECTION

PERMIT # 160465 PIN # 4669377412 DATE 6-2-2010

OWNER or APPLICANT Gary & Donna Ramey PHONE: Business 909 851-0977 Home: 704 528-4365

OWNER or APPLICANT ADDRESS 1165 Tennessee Circle Mooresville, NC 28117

LOCATION / DIRECTIONS Hwy 21 N TR Shinnville Rd past Springdale Sub. on right across from #663

SUBDIVISION Michael Shinn BLOCK / SECTION LOT # 1 LOT AREA 1.545Ac DESIGN FLOW 480gpd L.T.A.R. .3

Septic Tank 1000 Gallons: STB 583 Date 8-11-11

Pump Tank Gallons: P T Date

Pump Make Model Serial #

Nitrification Field No Fields 1 No Lines 5 Linear Feet 400'

Trench Width 36" Max. Trench Bottom Depth 36" Gravel Depth N/A

☒ New System ☐ Repair ☐ Expansion System Type I II III IV V VI

System Description: Gravity - 25% Reduction

Repair System Description: Gravity - 25-50% Reduct

Maintenance Agreement Required ☐ YES ☒ NO

☒ GRAVITY ☐ PRESSURE

☒ Residence No. Bedrooms 4 ☐ Business No. Persons ☐ Other No. Employees


☐ Slab ☐ Crawl Space ☐ Basement w/plumbing ☐ Basement w/o plumbing

Water Supply: ☒ Private ☐ Public ☐ Community

Comments / Conditions: Install drainlines on contour
Stay at least 10ft from property line.
Divert surface/storm water away from Drainfield


INITIAL SITE SKETCH

Scale 1:60

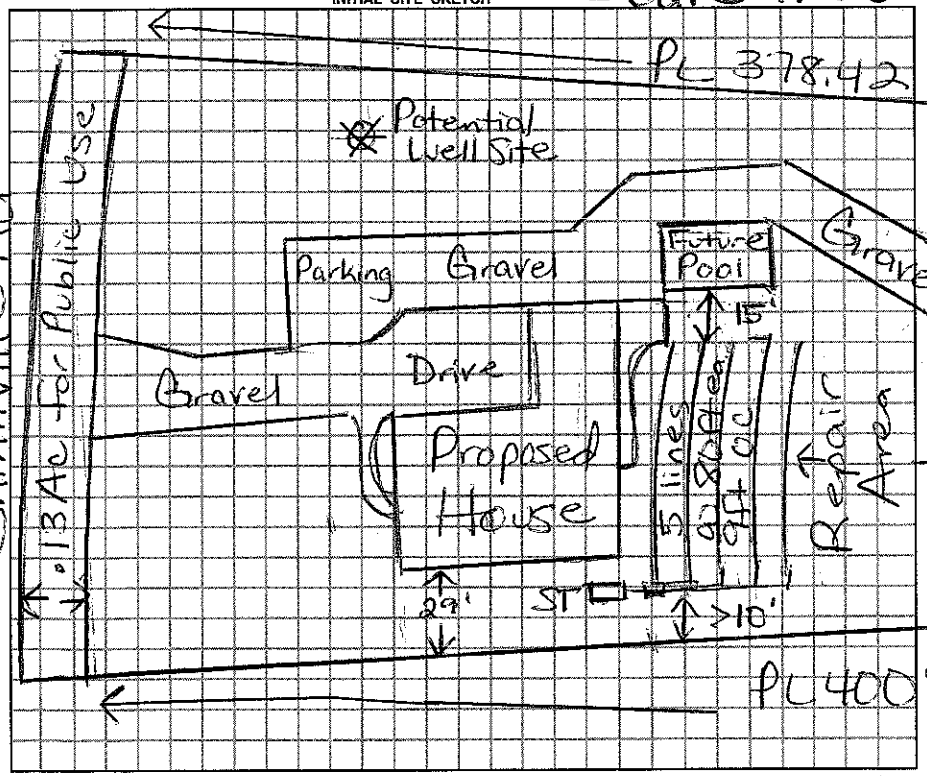

Comments / Conditions: REVIEWED PLANS (3 BDRooms ONLY)
9/15/2011 Checked ST & 1st 2 lines @4
9/16/2011 Checked last 2 lines
51ft from Corner of house to end of 1st trench.

AS BUILT SKETCH

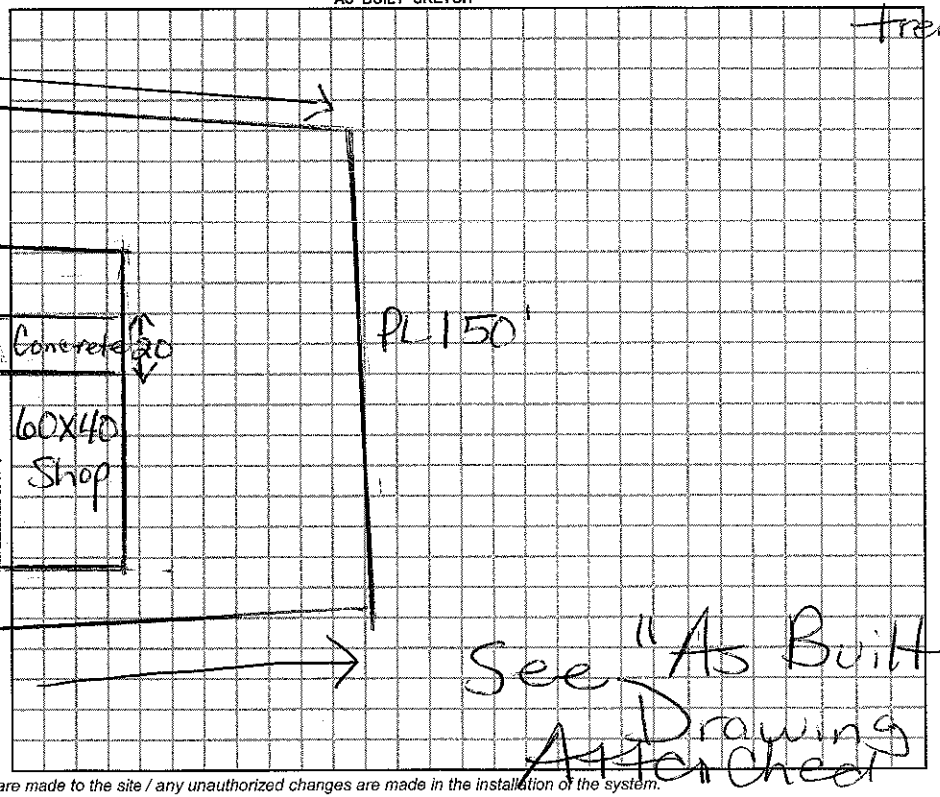

Permit can be suspended or revoked if any false information is supplied toward securing the permit / any unauthorized changes are made to the site / any unauthorized changes are made in the installation of the system.

☐ *IMPROVEMENT PERMIT w / plat valid without expiration.* ☐ *IMPROVEMENT PERMIT w / site plan valid for 60 mos.* ☒ *AUTHORIZATION TO CONSTRUCT valid for period equal to IMPROVEMENT PERMIT-not to exceed 60 mo.*

Owner / Applicant Signature Gary Ramey Date 6-3-10

Improvement Permit by: Mike Holt Coleman RS Date 6/2/2010

Authorzation to Construct by: RA 009 REHS Date 6-14-2011

Installed by: Rays Septic RS

Operation Permit by: Mike Holt Coleman Date: 9/16/2011

Existing System Inspected by: Date:

YOU SHOULD CONTACT A LOCATOR SERVICE PRIOR TO ANY EXCAVATION.

WHITE COPY Environmental Health YELLOW COPY (Final) Owner / Applicant PINK COPY (Initial) Owner / Applicant