
RETURN ASAP SO THE BUILDER MAY PROCEED!!!

FINAL ENGINEERED FLOORPLAN reflecting any/all changes

upper gable end window - centered

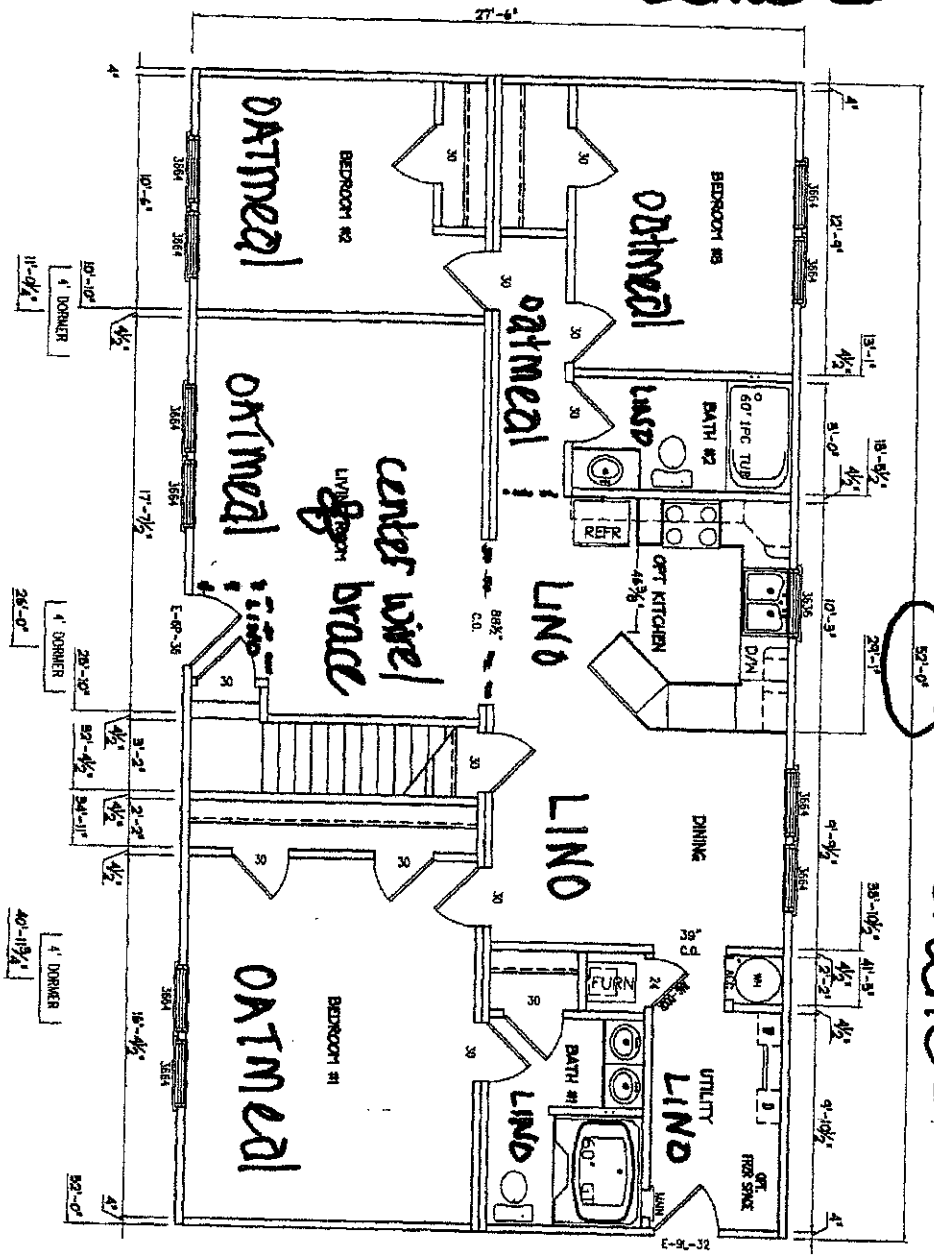

upper gable end window centered

AS BUILT COPY TO KEEP

- 2x 4 sidewalls
- 12/12 roof pitch

DRAWN CRC	DATE 4/22/2004	1st FLOOR PLAN	SELECT HOMES / BALDWIN	201
REV.	DATE		52'-0"x27'-6"	
SCALE 3/16"=1'-0"			150 W/ 160 KITCHEN	