4669380457

IREDELL COUNTY HEALTH DEPARTMENT

STATESVILLE 704-878-5305 MOORESVILLE 704-664-5281

$100.00 Pd.

IMPROVEMENT PERMIT / AUTHORIZATION TO CONSTRUCT / OPERATION PERMIT / EXISTING SYSTEM INSPECTION

PERMIT# 113640 / ~~13348~~ PIN# 4669 38 05 33 DATE 3/15/06

OWNER OR APPLICANT Jim Estes PHONE: Business 704 489 4497 Home

ADDRESS Po Box 367 Terrell NC 28682

LOCATION 115 N, TR Shinaville, on Lt #749

SUBDIVISION Lizauskas Acres BLOCK / SECTION LOT 2A LOT AREA 1.344Ac SITE CLASS. PS DESIGN FLOW 440/100 L.T.A.R. 0.35

Septic Tank: 1000 Gallons: STR 1512 Date 10/10/05

2nd ~~Septic~~ Tank: 1000 Gallons: one Line @ 80' 25% Red.

Pump Make: Model Serial No.

Nitrification Field: No Fields 1 Square Feet 1028 Linear Feet 343

No Lines 4 Trench Width 36" Max Trench Bottom Depth 36"

☒ New System ☐ Repair ☐ Expansion System Type: I II III IV V VI

System Description: 25% Reduction

Repair System Description: Pump Panel Block

Maintenance Agreement Required: ☐ Yes ☐ No

☒ House/Mod. Home ☐ Mobile Home ☐ Business ☐ Other


No. Bedrooms 4 No. Persons No. Employees

Water Supply: ☒ Individual ☐ Public ☐ Community

Gravity ☐ Pressure ☐ Slab ☐ Crawl Space ☐ Basement w/plumbing ☐ Basement wo/plumbing


Comments/Conditions:

INITIAL SITE SKETCH

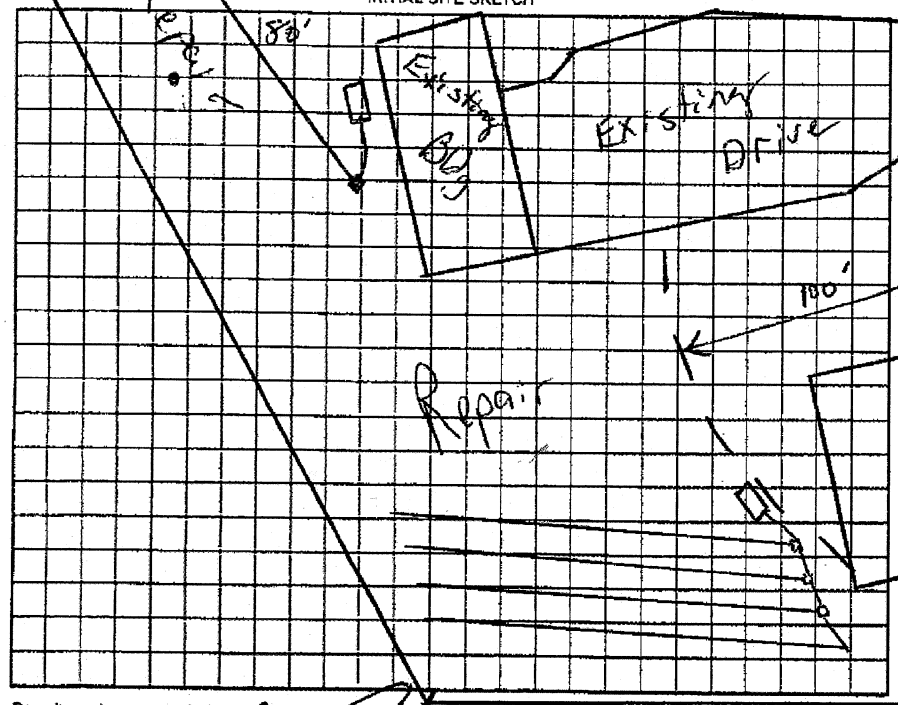

Comments/Conditions:

AS BUILT SKETCH

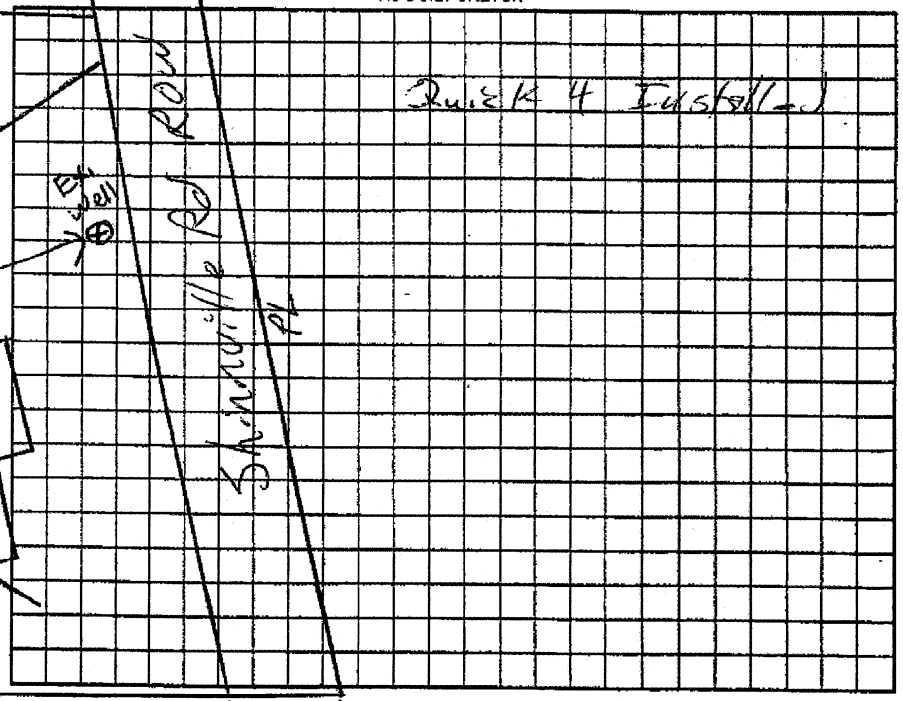

Permit can be suspended or revoked if any false information is supplied toward securing the permit/any unauthorized changes are made to the site/any unauthorized changes are made in the installation of the system. Improvement Permit with plat valid without expiration ☐ Improvement Permit with site plan valid for sixty months ☒ Authorization to Construct is valid for a period equal to that of Improvement Permit – not to exceed sixty months.

Signed: date 5-15-06 Installed by: Tommy Frye

Improvement Permit by: RS date 3/15/06 Operation Permit by: RS date 5/25/06

Authorization to Construct by: RS date 3/15/06 Existing System Inspection by: date

HEALTH DEPT. COPY: WHITE OWNER COPY (FINAL): YELLOW OWNER COPY (INITIAL): PINK